

SURVEY & REMONUMENTATION

JAN 19 1999

SECTION

LAND CORNER RECORDATION CERTIFICATE
Filing Requirement of Act 74, Mich. P.A. 1970

For corners in

<u>Iron</u> (County)	Located In:	Corner Code #	
1. Public Land Survey	T <u>44N</u> R <u>33W</u>	<u>H-7</u>	
	T _____ R _____	_____	
	T _____ R _____	_____	
	T _____ R _____	_____	
2. Property Controlling in Section	S _____ T _____ R _____	_____	
	S _____ T _____ R _____	_____	
3. Miscellaneous Property in Sec.	S _____ T _____ R _____	_____	
	S _____ T _____ R _____	_____	

IRON COUNTY
MICHIGAN
RECEIVED FOR RECORD

98 DEC 28 AM 11:13
L.C. Records: L. 7, P. 248
Gary L. Pisoni
REGISTERED LAND SURVEYOR

Register of Deeds Stamp & File Number

4. Lot No. _____, Recorded Plat _____
5. Private Claims _____

Quarter Corner Sections 15 and 22, T44N, R33W

I, Gary L. Pisoni, in a field survey on October 24, 1998 do hereby state that under requirements of P.A. 74, Michigan P.A. of 1970, the corner points mentioned in lines 1 and 2 above were in conformance with regulations and rules therefore as required in the current manual of survey instructions of the United States Department of the Interior, Bureau of Land Management or by a decree of a Court of Law and /or that the corner points mentioned in lines 3, 4 and 5 above were in conformance with the rules of the Michigan Board of Land Surveyors or by a Decree of a Court of Law; established, re-established, monumented, recovered, found as expressed below:

	A	B	C	D	E	F	G	H	I	J	K	L	M
1													
2		6		5		4		3		2		1	
3													
4		7		8		9		10		11		12	
5													
6		18		17		16		15		14		13	
7								●					
8		19		20		21		22		23		24	
9													
10		30		29		28		27		26		25	
11													
12		31		32		33		34		35		36	
13													

NOTE: Not more than 2 corners, all in the same town and range, may be recorded on this certificate.

A. Description of original monument and accessories and/or subsequent restoration:

Original corner established in June 1851 by Guy H. Carleton, U.S. Deputy Surveyor.

Original Corner; Wood Post
Original Bearing Trees:

Sugar	16"	N 44° W	21 lks (13.86 feet)
Yellow Birch	12"	S 44° W	31 lks (20.46 feet)

B. Description of corner evidence found and/or method applied in restoring or reestablishing corner:

No evidence of original B.T.s found.

In 1981, found a 1" diameter threaded bolt with nut on top located in middle of driveway, buried 10" below roadbed surface. In 1998, found a rebar pin over the top of the buried bolt, located in the middle of a driveway and in line with the centerline of a county road running South and East. I accept the rebar pin as the best available evidence for restoring the corner position.

Corner checks well with other GLO corners to the East and West.

Corner record research on file with County Representative.

PEER GROUP APPROVED
Gary L. Pisoni 11-24-98
COUNTY REPRESENTATIVE


C. Description of monument for corner and accessories established to perpetuate locating the position of the corner:

At the corner position, set a 3" diameter aluminum cap over the top of the existing rebar pin and stamped as follows: Iron County Remonumentation, T44N, R33W, 1/4, S-15, S-22, 1998, RLS 27457 from which I established the following new blazed and scribed bearing trees: (All measurements taken to a nail in side of tree)

White Spruce	8"	N 48° E	51.50 feet
Power Pole #87-24544		S 40° E	82.15 feet
White Spruce	23"	S 27° W	36.61 feet
White Spruce	17"	N 42° W	41.08 feet
Steel sign post		North	17.30 feet

98-71
Signed by Gary L. Pisoni Date 12-21-98
Surveyor's Michigan License No. 27457

FORM APPROVED BY MICHIGAN STATE BOARD OF PROFESSIONAL SURVEYORS, JAN. 28, 1971
NO. 27457
REVISED MAY 14, 1975
REVISED JAN., 1983
REVISED OCT., 1995

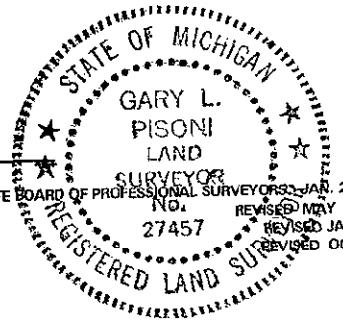

L. 7 P. 248