

**SURVEY &
REMONUMENTATION**

JAN 19 1999

SECTION

**LAND CORNER RECORDATION CERTIFICATE
Filing Requirement of Act 74, Mich. P.A. 1970**

For corners in

Iron <small>(County)</small>	Located In:	Corner Code #
1. Public Land Survey	T <u>44N</u> R <u>33W</u>	<u>H-9</u>
	T _____ R _____	_____
	T _____ R _____	_____
	T _____ R _____	_____
2. Property Controlling in Section	S _____ T _____ R _____	_____
	S _____ T _____ R _____	_____
3. Miscellaneous Property in Sec.	S _____ T _____ R _____	_____
	S _____ T _____ R _____	_____

IRON COUNTY
MICHIGAN
RECEIVED FOR RECORD

98 DEC 28 AM 11:17

L.C. Record: L. 7, P. 273

Richard Stiles

Register of Deeds Stamp & File Number

4. Lot No. _____, Recorded Plat _____
5. Private Claims _____

Quarter Corner Sections 22 and 27, T44N, R33W

I, Gary L. Pisoni, in a field survey on Nov. 4, 1998 do hereby state that under requirements of P.A. 74, Michigan P.A. of 1970, the corner points mentioned in lines 1 and 2 above were in conformance with regulations and rules therefore as required in the current manual of survey instructions of the United States Department of the Interior, Bureau of Land Management or by a decree of a Court of Law and /or that the corner points mentioned in lines 3, 4 and 5 above were in conformance with the rules of the Michigan Board of Land Surveyors or by a Decree of a Court of Law; established, re-established, monumented, recovered, found as expressed below:

	A	B	C	D	E	F	G	H	I	J	K	L	M
1													
2		6		5		4		3		2		1	
3													
4		7		8		9		10		11		12	
5													
6		18		17		16		15		14		13	
7													
8		19		20		21		22		23		24	
9								●					
10		30		29		28		27		26		25	
11													
12		31		32		33		34		35		36	
13													

NOTE: Not more than 2 corners, all in the same town and range, may be recorded on this certificate.

A. Description of original monument and accessories and/or subsequent restoration:

Original corner established in June, 1851 by Guy H. Carleton, Deputy Surveyor.
Original Corner: Wood Post
Original Bearing Trees:
Sugar 10" N 02° E 21 links (13.86 feet)
Cedar 8" S 25° W 22 links (14.52 feet)

On 9/27/67, C.C. Lindgren, RLS M.D.O.T., found a 12" squared post marking the corner position with a fence line running North and South. He replaced the squared post and set an iron bar inside a monument box marking the corner position.

1967 Bearing Trees:
Fence Post West 7.0 feet
Poplar 8" S 65° E 15.97 feet
Poplar 3" N 25° E 13.82 feet

PEER GROUP APPROVED
Iron H. Pisoni 12-18-98
COUNTY REPRESENTATIVE

B. Description of corner evidence found and/or method applied in restoring or reestablishing corner:


No evidence of original B.T.s found. Found a iron bar inside monument box as described above. Monument box located along South edge of a private driveway on West side of Hwy. 141.

The distances East and West do not agree with GLO as shown below, but the fence lines date back to the early 1900's. I accept the iron bar as the best available evidence for restoring the corner position.

Corner record research on file with County Representative.

C. Description of monument for corner and accessories established to perpetuate locating the position of the corner:
From the above described corner position, I set two reference monuments, being a 5/8" diameter by 30" long rebar, with a 3" aluminum cap stamped as follows: Iron County Remonumentation, T44N, R33W, R.M., 1/4, S-22, S-27, N 39° W, 10.45', 1998, RLS 27457, T44N, R33W, R.M., 1/4, S-22, S-27, S 64° E, 30.92', 1998, RLS 27457 from which the following reference objects bear:

R.M.	5/8" x 30" rebar	S 39° E	10.45 feet
R.M.	5/8" x 30" rebar	N 64° W	30.92 feet
Rebar	5/8" x 30"	N 21° W	29.80 feet
Centerline of Hwy. 141		N 52° E	63.80 feet
Steel sign post		S 39° E	11.33 feet
NW corner Section 27		S 89° 05'46"W	2694.71 feet
NE corner Section 27		N 89° 34'52"E	2600.09 feet

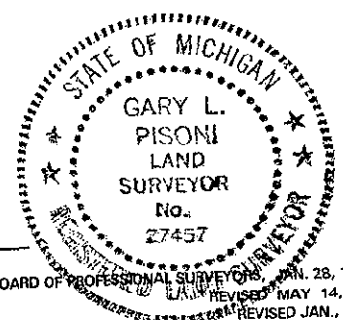

98-76
Signed by Gary L. Pisoni Date 12-21-98
Surveyor's Michigan License No. 27457

1.7 P. 273