

**SURVEY &
REMONUMENTATION**

JAN 19 1999

SECTION

**LAND CORNER RECORDATION CERTIFICATE
Filing Requirement of Act 74, Mich. P.A. 1970**

For corners in

Iron	Located In:	Corner Code #
(County)		
1. Public Land Survey	T 44N R 33W	K-11
	T _____ R _____	_____
	T _____ R _____	_____
	T _____ R _____	_____
2. Property Controlling in Section	S _____ T _____ R _____	_____
	S _____ T _____ R _____	_____
3. Miscellaneous Property in Sec.	S _____ T _____ R _____	_____
	S _____ T _____ R _____	_____

IRON COUNTY
MICHIGAN
RECEIVED FOR RECORD

98 DEC 28 AM 11:12

L.C. Records: L. 7, P. 245

Gilbert J. Pisoni
REGISTERED LAND SURVEYOR

Register of Deeds Stamp & File Number

4. Lot No. _____, Recorded Plat _____
5. Private Claims _____

Section Corner Sec. 25, 26, 35, 36, T44N, R33W

I, Gary L. Pisoni, in a field survey on October 22, 1998 do hereby state that under requirements of P.A. 74, Michigan P.A. of 1970, the corner points mentioned in lines 1 and 2 above were in conformance with regulations and rules therefore as required in the current manual of survey instructions of the United States Department of the Interior, Bureau of Land Management or by a decree of a Court of Law and /or that the corner points mentioned in lines 3, 4 and 5 above were in conformance with the rules of the Michigan Board of Land Surveyors or by a Decree of a Court of Law; established, re-established, monumented, recovered, found as expressed below:

	A	B	C	D	E	F	G	H	I	J	K	L	M
1													
2	6		5		4		3		2		1		
3													
4	7		8		9		10		11		12		
5													
6	13		17		16		15		14		13		
7													
8	19		20		21		22		23		24		
9													
10	30		29		28		27		26		25		
11													
12	31		32		33		34		35		36		
13													

NOTE: Not more than 2 corners, all in the same town and range, may be recorded on this certificate.

A. Description of original monument and accessories and/or subsequent restoration:

Original corner established in 1851 by Guy H. Carleton, U.S. Deputy Surveyor.
Original Corner; Wood Post
Original Bearing Trees:
Sugar 18" N 20°E 34 lks (22.44 feet)
Sugar 18" S 15°E 11 lks (7.26 feet)

PEER GROUP APPROVED
Iron A. Rose 11-24-98
COUNTY REPRESENTATIVE

B. Description of corner evidence found and/or method applied in restoring or reestablishing corner:

No evidence of original B.T.s found.

Found a 4" diameter brass cap with MDNR Fisheries Division identification set by G.A. Shadko RLS on 12/18/62. Monument flush with ground surface and located on a rock fence line running North, East and West, stamped as follows: DNR, T44N, R33W, S-25, S-26, S-35, S-36, 12/18/62, G.A. Shadko RLS.

I accept the monument as the best available evidence for restoring the corner position.

Corner record research on file with County Representative.


C. Description of monument for corner and accessories established to perpetuate locating the position of the corner:

From the above described monument, blazed and scribed the following new bearing trees: (All measurements taken to a nail in side of tree)

Sugar Maple	11"	N 83° W	22.65 feet
Sugar Maple	10"	N 14° W	17.19 feet
Balsam	6"	N 73° E	28.11 feet
Steel sign post		N 15° E	0.75 feet

98-84
Signed by *Gary L. Pisoni* Date 12-21-98
Surveyor's Michigan License No. 27457

FORM APPROVED BY MICHIGAN STATE BOARD OF PROFESSIONAL SURVEYORS, JAN. 28, 1971
NOT REVISION MAY 24, 1975
27457 REVISION JAN 5, 1983

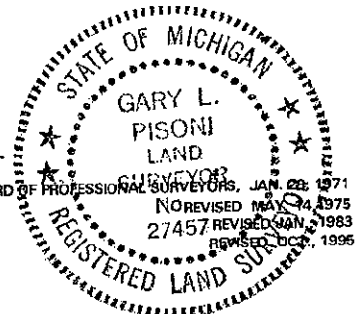

L. 7 P. 245