

SURVEY & REMONUMENTATION

JAN 19 1999

SECTION

LAND CORNER RECORDATION CERTIFICATE
Filing Requirement of Act 74, Mich. P.A. 1970

For corners in

<u>Iron</u> (County)	Located in:	Corner Code #
1. Public Land Survey	T <u>44N</u> R <u>33W</u>	<u>K-12</u>
	T _____ R _____	_____
	T _____ R _____	_____
	T _____ R _____	_____
2. Property Controlling in Section	S _____ T _____ R _____	_____
	S _____ T _____ R _____	_____
3. Miscellaneous Property in Sec.	S _____ T _____ R _____	_____
	S _____ T _____ R _____	_____

IRON COUNTY
MICHIGAN
RECEIVED FOR RECORD

98 DEC 28 AM 11:12

L.C. Records: L. J. P. 244

Robert Stiles

REGISTERED DEEDS

Register of Deeds Stamp & File Number

4. Lot No. _____, Recorded Plat _____
5. Private Claims _____

Quarter Corner between Sec. 35 and 36, T44N, R33W

I, Gary L. Pisoni, in a field survey on October 22, 1998 do hereby state that under requirements of P.A. 74, Michigan P.A. of 1970, the corner points mentioned in lines 1 and 2 above were in conformance with regulations and rules therefore as required in the current manual of survey instructions of the United States Department of the Interior, Bureau of Land Management or by a decree of a Court of Law and /or that the corner points mentioned in lines 3, 4 and 5 above were in conformance with the rules of the Michigan Board of Land Surveyors or by a Decree of a Court of Law; established, re-established, monumented, recovered, found as expressed below:

NOTE: Not more than 2 corners, all in the same town and range, may be recorded on this certificate.

1	A	B	C	D	E	F	G	H	I	J	K	L	M
2		6		5		4		3		2		1	
3													
4		7		8		9		10		11		12	
5													
6		18		17		16		15		14		13	
7													
8		19		20		21		22		23		24	
9													
10		30		29		28		27		26		25	
11													
12		31		32		33		34		35		36	
13													

A. Description of original monument and accessories and/or subsequent restoration:

Original corner established in 1851 by Guy H. Carleton, U.S. Deputy Surveyor.
Original Corner; Wood Post
Original Bearing Trees:

Elm	8"	S 55° W	33 lks (21.78 feet)
Yellow Birch	10"	N 25° E	57 lks (37.62 feet)

PEER GROUP APPROVED
Iron County 11-24-98
COUNTY REPRESENTATIVE

B. Description of corner evidence found and/or method applied in restoring or reestablishing corner:

No evidence of original B.T.s found.

Found a 4" diameter brass cap with MDNR Fisheries Division identification set by G.A. Shadko RLS in the centerline of an East/West county road and a North/South fence line. Monument is 10" below road bed surface, stamped as follows: DNR, T44N, R33W, 1/4, S-35, S-36, 1962, G.A. Shadko RLS. I accept the monument as the best available evidence for restoring the corner position.

Distances to the North and South are consistent with GLO distances.

Corner record research on file with County Representative.


C. Description of monument for corner and accessories established to perpetuate locating the position of the corner:

From the above described monument, blazed and scribed the following new bearing trees: (All measurements taken to a nail in side of tree)

Rebar	5/8" x 30"	N 57° E	42.66 feet
Maple	13"	S 30° E	50.80 feet
Maple	12"	S 02° W	49.60 feet
Rebar	5/8"x30"	S 27° W	35.46 feet
Steel sign post		S 02° W	28.86 feet

98-87
Signed by Gary L. Pisoni Date 11-21-98
Surveyor's Michigan License No. 27457

FORM APPROVED BY MICHIGAN STATE BOARD OF PROFESSIONAL SURVEYORS, JAN. 23, 1971
REVISED MAY 13, 1975
REVISED JAN. 1983
REVISED OCT. 1995

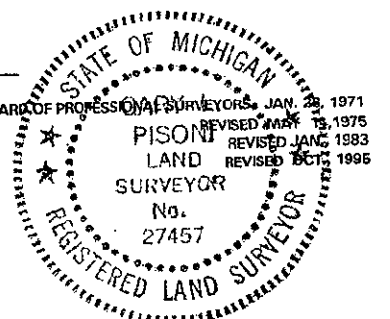

L.7 P.244