

**SURVEY &  
REMONUMENTATION**

JAN 19 1999

**SECTION**

**LAND CORNER RECORDATION CERTIFICATE  
Filing Requirement of Act 74, Mich. P.A. 1970**

For corners in

Iron <small>(County)</small>	Located In:	Corner Code #
1. Public Land Survey	T <u>43N</u> R <u>33W</u>	<u>K-1</u>
	T <u>44N</u> R <u>33W</u>	<u>K-13</u> ✓
	T _____ R _____	_____
	T _____ R _____	_____
2. Property Controlling in Section	S _____ T _____ R _____	_____
	S _____ T _____ R _____	_____
3. Miscellaneous Property in Sec.	S _____ T _____ R _____	_____
	S _____ T _____ R _____	_____

IRON COUNTY  
MICHIGAN  
RECEIVED FOR RECORD  
  
98 DEC 28 AM 11:12  
L.C. Records: L.7, P. 243  
  
*Gary L. Pisoni*  
REGISTERED LAND SURVEYOR  
  
Register of Deeds Stamp & File Number

4. Lot No. \_\_\_\_\_, Recorded Plat \_\_\_\_\_  
5. Private Claims \_\_\_\_\_

Section Corner Sec. 1 and 2, T43N, R33W  
Section Corner Sec. 35 and 36, T44N, R33W

I, Gary L. Pisoni, in a field survey on October 22, 1998 do hereby state that under requirements of P.A. 74, Michigan P.A. of 1970, the corner points mentioned in lines 1 and 2 above were in conformance with regulations and rules therefore as required in the current manual of survey instructions of the United States Department of the Interior, Bureau of Land Management or by a decree of a Court of Law and/or that the corner points mentioned in lines 3, 4 and 5 above were in conformance with the rules of the Michigan Board of Land Surveyors or by a Decree of a Court of Law; established, re-established, monumented, recovered, found as expressed below:

	A	B	C	D	E	F	G	H	I	J	K	L	M
1													
2	6		5		4		3		2		1		
3													
4	7		8		9		10		11		12		
5													
6	18		17		16		15		14		13		
7													
8	19		20		21		22		23		24		
9													
10	30		29		28		27		26		25		
11													
12	31		32		33		34		35		36		
13													

**NOTE:** Not more than 2 corners, all in the same town and range, may be recorded on this certificate.

**A. Description of original monument and accessories and/or subsequent restoration:**

Original corner established on August 6, 1846 by Austin Burt, U.S. Deputy Surveyor.

Original Corner; Sugar Post

Original Bearing Trees:

Sugar	8"	N 37 1/2° E	32 lks (21.12 feet)
Sugar	12"	N 27 1/2° W	40 lks (26.40 feet)

Original Subdivision established by Guy H. Carleton, Deputy Surveyor in September 1851.

Original Bearing Trees:

Sugar	9"	S 40° W	17 lks (11.22 feet)
Sugar	10"	S 70° E	25 lks (16.50 feet)

PEER GROUP APPROVED  
*Gary L. Pisoni 11-24-98*  
COUNTY REPRESENTATIVE

On 4-24-70, Arthur O. Enger, RLS found a 4" X 36" concrete filled iron pipe with MDNR Fisheries Division brass Identification marker set by G.A. Shadko, RLS on 11-2-62, in center of road in line with old fences running to North and South. Monument found frost heaved out of road bed. Placed a plain iron pipe in road, and reset Shadko's monument 32.50 feet North of it for a witness corner (R.M.) stamped as follows: DNR, T44N, R33W, R.M., S-35, S-36, S-2, S-1, 11/2/62, G.A. Shadko RLS; recorded in L.C. Certificate Liber 1, Pages 135-136.

1970 Bearing Trees:

Yellow Birch	12"	S 24 1/2° W	47.73 feet
Maple	6"	N 47 1/2° W	46.47 feet

**B. Description of corner evidence found and/or method applied in restoring or reestablishing corner:**

No evidence of original B.T.s found.

Found monument as set by Arthur O. Enger in 1970. Iron pipe is 5" below roadbed surface and in centerline of road and the following bearing objects:

Ref. Mon.		N 02° E	33.22 feet
Sugar Maple	7"	N 46° W	46.67 feet

Corner record research on file with County Representative.

**C. Description of monument for corner and accessories established to perpetuate locating the position of the corner:**


Blazed and scribed the following new bearing trees: (All measurements taken to a nail in side of tree)

Sugar Maple	11"	N 09° E	24.55 feet
Sugar Maple	10"	S 24° W	66.40 feet
Steel sign post		N 02° E	33.72 feet

98-88  
Signed by Gary L. Pisoni Date 12-21-98

Surveyor's Michigan License No. 27457

FORM APPROVED BY MICHIGAN STATE BOARD OF PROFESSIONAL SURVEYORS, JAN. 28, 1974

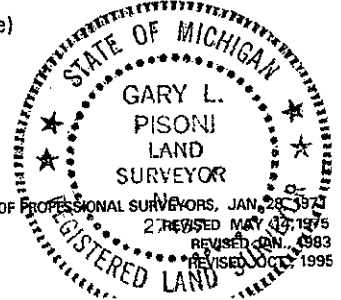

L.7 P.243