

**SURVEY & REMONUMENTATION**

**JAN 13 1998**

**SECTION**

IRON COUNTY  
MICHIGAN  
RECEIVED FOR RECORD

97 DEC 23 PM 1:27  
L.C. Records L.7 P.128

*Gilbert J. Jiles*  
REGISTER OF DEEDS

**LAND CORNER RECORDATION CERTIFICATE**  
Filing Requirement of Act 74, Mich. P.A. 1970

For corners in

_____ Iron _____ (County)	Located In:	Corner Code #
1. Public Land Survey	T <u>44N</u> R <u>32W</u>	A-8
	T <u>44N</u> R <u>33W</u>	M-8
	T _____ R _____	_____
	T _____ R _____	_____
2. Property Controlling in Section	S _____ T _____ R _____	_____
	S _____ T _____ R _____	_____
3. Miscellaneous Property in Sec.	S _____ T _____ R _____	_____
	S _____ T _____ R _____	_____
4. Lot No. _____, Recorded Plat _____		
5. Private Claims _____		

Register of Deeds Stamp & File Number

Quarter Corner Sec. 19, T44N, R32W  
Quarter Corner Sec. 24, T44N, R33W

I, Gary L. Pisoni, in a field survey on November 5, 1997 do hereby state that under requirements of P.A. 74, Michigan P.A. of 1970, the corner points mentioned in lines 1 and 2 above were in conformance with regulations and rules therefore as required in the current manual of survey instructions of the United States Department of the Interior, Bureau of Land Management or by a decree of a Court of Law and /or that the corner points mentioned in lines 3, 4 and 5 above were in conformance with the rules of the Michigan Board of Land Surveyors or by a Decree of a Court of Law; established, re-established, monumented, recovered, found as expressed below:

	A	B	C	D	E	F	G	H	I	J	K	L	M
1													
2	6			5		4		3		2			1
3													
4	7			8		9		10		11			12
5													
6	18			17		16		15		14			13
7													
8	19			20		21		22		23			24
9													
10	30			29		28		27		26			25
11													
12	31			32		33		34		35			36
13													

NOTE: Not more than 2 corners, all in the same town and range, may be recorded on this certificate.

A. Description of original monument and accessories and/or subsequent restoration:

Original corner established in 1846 by Austin Burt, U.S. Deputy Surveyor.

Original Corner; Sugar Post  
Original Bearing Trees:

Lynn	16"	S53°E	21 links (13.86 feet)
Sugar	7"	N72°W	37 links (24.42 feet)

B. Description of corner evidence found and/or method applied in restoring or reestablishing corner:

No original or subsequent corner evidence recovered.

I restored the corner position by single proportionate measurement between the Northwest and Southwest Section Corners of Section 19.

Corner record research on file with County Representative.


C. Description of monument for corner and accessories established to perpetuate locating the position of the corner:

At the corner position, set a 3/4" outside diameter aluminum rod monument, 3 feet long, 3 inches above the ground with an aluminum cap stamped as follows; Iron County Remonumentation, T44N, R33W, R32W, 1/4, S24, S19, 1997, RLS 27457. Blazed and scribed the following new bearing trees; (All measurements taken to a nail in side of tree)

Sugar Maple	8"	N49°E	26.79 feet
Basswood	9"	S70°E	7.98 feet
Sugar Maple	8"	S22°W	36.37 feet
Sugar Maple	7"	S76°W	14.36 feet
Steel Sign Post		N45°W	0.67 feet

PEER GROUP APPROVED

*Gary L. Pisoni 11-11-97*  
IRON COUNTY REMONUMENTATION

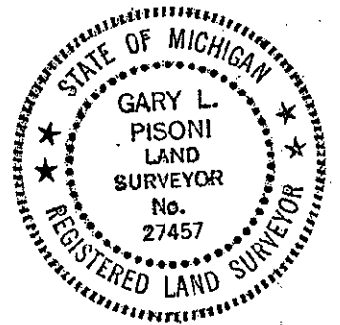

97-23  
Signed by *Gary L. Pisoni*  
Surveyor's Michigan License No. 27457

Date November 7, 1997