

LAND CORNER RECORDATION CERTIFICATE
Filing Requirement of Act 74, Mich. P.A. 1970 as Amended

For corners in

<u>Iron County</u> <small>(County)</small>	Located In:	Corner Code #	
1. Public Land Survey	T <u>44N</u> R <u>33W</u>	<u>7a - MC S. of C7</u>	
	T _____ R _____	_____	
	T _____ R _____	_____	
	T _____ R _____	_____	
2. Property Controlling in Section	S _____ T _____ R _____	_____	
	S _____ T _____ R _____	_____	
3. Miscellaneous Property in Sec.	S _____ T _____ R _____	_____	
	S _____ T _____ R _____	_____	
4. Lot No. _____, Recorded Plat _____			
5. Private Claims _____			

Register of Deeds Stamp & File Number

	A	B	C	D	E	F	G	H	I	J	K	L	M
1													
2	6	5	4	3	2	1							
3													
4	7	8	9	10	11	12							
5													
6	18	17	16	15	14	13							
7													
8	19	20	21	22	23	24							
9													
10	30	29	28	27	26	25							
11													
12	31	32	33	34	35	36							
13													

I, Stephan J. Szyszkoski, in a field survey on May 12, 2003 do hereby state that under requirements of P.A. 74, Michigan P.A. of 1970, the corner points mentioned in lines 1 and 2 above were in conformance with regulations and rules therefore as required in the current manual of survey instructions of the United States Department of the Interior, Bureau of Land Management or by a decree of a Court of Law and /or that the corner points mentioned in lines 3, 4 and 5 above were in conformance with the rules of the Michigan Board of Land Surveyors or by a Decree of a Court of Law; established, re-established, monumented, recovered, found as expressed below:

NOTE: Not more than 2 corners, all in the same town and range, may be recorded on this certificate.

A. Description of original monument and accessories and/or subsequent restoration:

Witness corner to Meander Corner on north shore of Fire Lake between Sections 19 and 20). Recorded by A.O. Enger in 1980:


"Restored 5-7-79 on true sec. line on N edge of Fire Lake, 28.931 ch. S of Sec. Cor. and 10.429 ch. N of 1/4 cor. in lake. (Mon. is 28.854 ch. S of Sec. Cor. and 10.506 ch. N of 1/4 cor. in lake)." 1" IDx36" iron pipe with 3 3/4" alum. cap. Tamarack 9 N26E 40.3', Tamarack 5 N58W 28.8'.

B. Description of corner evidence found and/or method applied in restoring or reestablishing corner:

Recovered the 1979 monument and accessories in good condition. Did not accept that monument as marking the direction of the section line. I found a very old fence line, about 71' west of the 1979 monument, running at least 800' north from the north shore of the lake. It defines a reasonably straight line of long standing occupation composed of very old wire fence, cedar posts and remains of cedar posts, a 3/4" I.pipe monument (found 1104.98' S of C7), the westerly limits of clearing and improvements on a parcel immediately north of the N1/16 corner between Sections 19 and 20, and the monumented NE corner of Section 19. I note that the direction of this line does not conform to the GLO record, it bearing about N1 deg. 30' E of true north. Neither is it colinear or parallel with the East line of Sec. 19 as it was found monumented on the south side of Fire Lake. I note that this township was originally subdivided by Guy H. Carleton, a U.S. Deputy Surveyor who is known by the undersigned to have performed loose work. Despite the nonconformity with the record, I accept the established line as the best available evidence of the original Carleton section line north of the lake and place a MDNR monument on that line at the water's edge on the north shore of Fire Lake. Distance north to C7 is 1952.70'. This monument does not mark the position of the original Meander Corner, the original probably having been somewhat north. Removed the 1979 monument. The 1979 NBTs are still in place with the old markings overgrown.

C. Description of monument for corner and accessories established to perpetuate locating the position of the corner:

Set 1"IDx32" I.pipe with 4" alum. MDNR cap. Blazed, scribed, and set measuring nails in:
 6" dbl Cedar N27W 36.6' "WC BT"
 5" Cedar N05W 39.3' do
 5" Cedar N12E 40.7' do
 9" Tamarack N29E 27.6' do
 Placed squared cedar post adjacent. Bearings are magnetic. Distances are to nail with tag #33986.

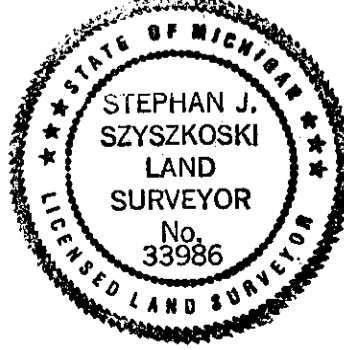

Signed by Stephan J. Szyszkoski Date June 12, 2003
 Surveyor's Michigan License No. P.S. 33986