

LAND CORNER RECORDATION CERTIFICATE
Filing Requirement of Act 74, Mich. P.A. 1970

For corners in

Iron

(County)

Located In:

Corner Code #

1. Public Land Survey	T	R	_____
	T	R	_____
	T	R	_____
	T	R	_____
2. Property Controlling in Section	S 19	T 44N R 33W	13
	S 19	T 44N R 33W	5
3. Miscellaneous Property in Sec.	S	T	R
	S	T	R

Register of Deeds Stamp & File Number

4. Lot No. _____, Recorded Plat _____
 5. Private Claims _____

May 14 2003

I, Stephan J. Szyszkoski, in a field survey on _____, 20__ do hereby state that under requirements of P.A. 74, Michigan P.A. of 1970, the corner points mentioned in lines 1 and 2 above were in conformance with regulations and rules therefore as required in the current manual of survey instructions of the United States Department of the Interior, Bureau of Land Management or by a decree of a Court of Law and /or that the corner points mentioned in lines 3, 4 and 5 above were in conformance with the rules of the Michigan Board of Land Surveyors or by a Decree of a Court of Law; established, re-established, monumented, recovered, found as expressed below:

NOTE: Not more than 2 corners, all in the same town and range, may be recorded on this certificate.


1	A	B	C	D	E	F	G	H	I	J	K	L	M
2		6		5		4		3		2		1	
3													
4		7		8		9		10		11		12	
5													
6		18		17		16		15		14		13	
7													
8		•		20		21		22		23		24	
9													
10		30		29		28		27		26		25	
11													
12		31		32		33		34		35		36	
13													

A. Description of original monument and accessories and/or subsequent restoration:
 (13-Sec. 19) Southeast 1/16 corner, Sec. 19. Not established in the original survey.
 (5-Sec. 19) North 1/16 corner, Section 19. Not established in the original survey.

B. Description of corner evidence found and/or method applied in restoring or reestablishing corner:
 (13-Sec. 19) Established the corner at the intersection of straight lines connecting opposite 1/16 corners.
 (5-Sec. 19) Established the corner midway and on a straight line between Center of Section 1325.20' South and 1/4 corner 1325.20' North.

C. Description of monument for corner and accessories established to perpetuate locating the position of the corner:

(13) Set 1"IDx32" I.pipe with 4" alum. MDNR cap. Blazed, scribed, and set measuring nails in: 7" Sugar N16E 11.8' "1/16S BT" 6" Sugar S88E 7.6' do 9" Sugar S12E 13.2' do 8" Sugar N70W 25.9' do Set sq'd cedar post adjacent. Bearings are magnetic. Distances are to nail with tag.	(5) Set 1"IDx32" I.pipe with 4" alum. MDNR cap. Blazed, scribed, and set measuring nails in: 4" Spruce N02E 40.7' "1/16S BT" 6" Maple S42E 33.2' do 16" Spruce S06W 5.8' do 10" Spruce N61W 35.0' do Set sq'd cedar post adjacent. Bearings are magnetic. Distances are to nail with tag.
--	--

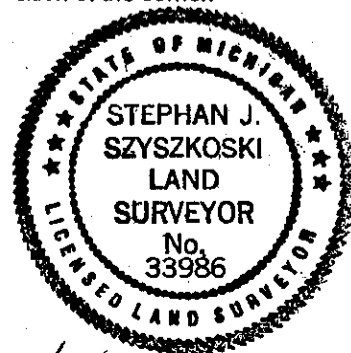

Signed by Stephan J. Szyszkoski
 Surveyor's Michigan License No. 33986

Date 6/11/03