


LAND CORNER RECORDATION CERTIFICATE
Filing Requirement of Act 74, Mich. P.A. 1970

For corners in

Iron	Located In:	Corner Code #
(County)		
1. Public Land Survey	T ___ R ___	_____
	T ___ R ___	_____
	T ___ R ___	_____
	T ___ R ___	_____
2. Property Controlling in Section	S 19 T 44N R 33W	9
	S 19 T 44N R 33W	6
3. Miscellaneous Property in Sec.	S ___ T ___ R ___	_____
	S ___ T ___ R ___	_____

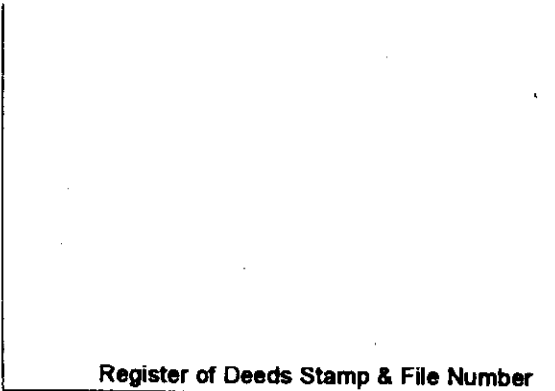

4. Lot No. _____, Recorded Plat _____
 5. Private Claims _____

Apr 24 2003

I, Stephan J. Szyszkoski, in a field survey on _____, 20__ do hereby state that under requirements of P.A. 74, Michigan P.A. of 1970, the corner points mentioned in lines 1 and 2 above were in conformance with regulations and rules therefore as required in the current manual of survey instructions of the United States Department of the Interior, Bureau of Land Management or by a decree of a Court of Law and/or that the corner points mentioned in lines 3, 4 and 5 above were in conformance with the rules of the Michigan Board of Land Surveyors or by a Decree of a Court of Law, established, re-established, monumented, recovered, found as expressed below:

NOTE: Not more than 2 corners, all in the same town and range, may be recorded on this certificate.


	A	B	C	D	E	F	G	H	I	J	K	L	M
1													
2		6		5		4		3		2		1	
3													
4		7		8		9		10		11		12	
5													
6		18		17		16		15		14		13	
7													
8		19		20		21		22		23		24	
9													
10		30		29		28		27		26		25	
11													
12		31		32		33		34		35		36	
13													

A. Description of original monument and accessories and/or subsequent restoration:
 (9-Sec. 19) East 1/16 corner, Section 19. Not established in the original survey.
 (6-Sec. 19) Northeast 1/16 corner, Section 19. Not established in the original survey.

B. Description of corner evidence found and/or method applied in restoring or reestablishing corner:
 (9-Sec. 19) Established the corner on the E-W 1/4 line 20.099 chains east of the Center of Section 19, the distance being one-half of the mean of the GLO record distances on the E North and South sides of the East one-half of Section 19.
 (6-Sec. 19) Established the corner at the intersection of 1/16 lines.

C. Description of monument for corner and accessories established to perpetuate locating the position of the corner:

(9) Set 1"IDx32" I.pipe with 4" alum. MDNR cap. Blazed, scribed, and set measuring nails in: 5" Balsam N25W 11.9' "1/16S 8T" 5" Sugar S67E 32.1' do 7" Spruce S22E 21.4' do 6" Sugar S33W 61.3' do Set sq'd cedar post adjacent. Bearings are magnetic. Distances are to nail with tag.	(6) Set 1"IDx32" I.pipe with 4" alum. MDNR cap. Blazed, scribed, and set measuring nails in: 8" Sugar N13E 14.3' "1/16S 8T" 7" Sugar S75E 6.3' do 8" Maple S39W 26.3' do 8" Maple N41W 14.1' do Set sq'd cedar post adjacent. Bearings are magnetic. Distances are to nail with tag.
--	---

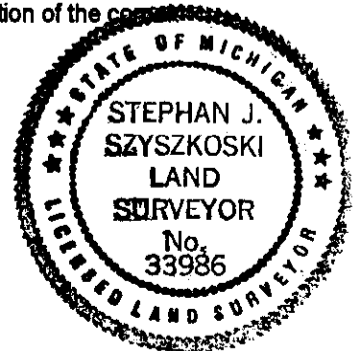

Signed by Stephan J. Szyszkoski Date 6/11/03
 Surveyor's Michigan License No. 33986