

**SURVEY &
REMONUMENTATION**

JAN 12 1996

COMMISSION

LAND CORNER RECORDATION CERTIFICATE
Filing Requirement of Act 74, Mich. P.A. 1970

IRON COUNTY
MICHIGAN
RECEIVED FOR RECORD

95 DEC 15 PM 2:22
LC Records L. 6, P. 416

Robert Stebbins
REGISTER OF DEEDS

For corners in

Iron (County)	Located In:	Corner Code #
1. Public Land Survey	T 44NR 35W	M-6
	T 44NR 34W	A-6
	T R	
	T R	
2. Property Controlling in Section	S T R	
	S T R	
3. Miscellaneous Property in Sec.	S T R	
	S T R	

Register of Deeds Stamp & File Number

4. Lot No. _____, Recorded Plat _____

5. Private Claims _____

Quarter Corner 13 & 18 T44n R35-34W

I, Gary L. Pisoni, in a field survey on Oct. 17, 19 95 do hereby state that under requirements of P.A. 74, Michigan P.A. of 1970, the corner points mentioned in lines 1 and 2 above were in conformance with regulations and rules therefore as required in the current manual of survey instructions of the United States Department of the Interior, Bureau of Land Management or by a decree of a Court of Law and /or that the corner points mentioned in lines 3, 4 and 5 above were in conformance with the rules of the Michigan Board of Land Surveyors or by a Decree of a Court of Law; established, re-established, monumented, recovered, found as expressed below:

NOTE: Not more than 2 corners, all in the same town and range, may be recorded on this certificate.

	A	B	C	D	E	F	G	H	I	J	K	L	M
1													
2	6		5		4		3		2		1		
3													
4	7		8		9		10		11		12		
5													
6	18		17		16		15		14		13		
7													
8	19		20		21		22		23		24		
9													
10	30		29		28		27		26		25		
11													
12	31		32		33		34		35		36		
13													

A. Description of original monument and accessories and/or subsequent restoration:

Original corner established by William Burt, U.S Deputy Surveyor on September 15, 1846.
Original corner: 12" Hemlock corner tree
Original bearing tree: Cedar 14" N 50°W 3 links (1.98 feet)
Arthur Enger RLS for MDNR on 11/02/76 recovered original cedar BT stump and set a 1" I.D. x 36" iron pipe with a stamped 3 3/4" aluminum cap and established the following bearing trees:
Cedar 10" S 04°W 29.00 feet
Cedar 6" N 06°W 17.70 feet
USFS Monument N 59°19'W 60.50 feet

B. Description of corner evidence found and/or method applied in restoring or reestablishing corner:

No original corner evidence found. Found a DNR aluminum capped pipe monument at corner position set by arthur Enger RLS on 11/2/76 and recorded in Liber 1 of L.C. Records, P. 547-548. DNR 1/4 corner between Section 13 & 18 check good for distance and bearing to the Northeast and Southeast section corners of Section 13, T44N R35W. Also found a USFS brass capped pipe monument set by Donald D. Lappala RLS recorded in Liber 3 of L.C. Records, P. 45 marking corner position. I reject the USFS monument as the 1/4 corner because it is located approximately 60 feet to far West and doesn't fit very well with the Section corners to the North and South.


ACT 74 Research on file with County Representative

PEER GROUP APPROVED
Gary L. Pisoni 12-14-95

C. Description of monument for corner and accessories established to perpetuate locating the position of the corner: COUNTY REPRESENTATIVE

From the above described aluminum cap monument, I established the following new blazed and scribed bearing trees: (all measurements taken to a nail in side of tree)

Cedar (Exist)	12"	N 19°W	17.82 feet
Cedar (NBT)	10"	N 52°E	26.83 feet
Cedar (Exist)	12"	S 05°W	29.43 feet
Cedar (NBT)	13"	N 60°W	37.42 feet
Steel Sign Post		S 13°W	0.55 feet
USFS Monument		N 59°17'41"W	60.61 feet

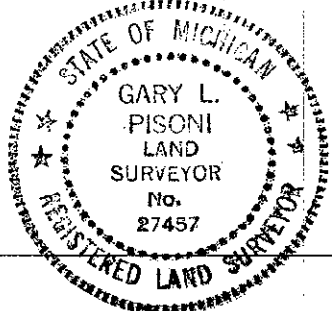

Signed by Gary L. Pisoni
Surveyor's Michigan License No. 27457

Date 11-30-95