

**SURVEY &
REMONUMENTATION**

JAN 12 1996

COMMISSION

**LAND CORNER RECORDATION CERTIFICATE
Filing Requirement of Act 74, Mich. P.A. 1970**

IRON COUNTY
MICHIGAN
RECEIVED FOR RECORD

95 DEC 15 PM 2:22

LC Records L.6, P. 415

Gilbert Stebbins
REGISTER OF DEEDS

For corners in

Iron (County)	Located In:	Corner Code #
1. Public Land Survey	T44N R35W	M-7
	T44N R34W	A-7
	T R	
	T R	
2. Property Controlling in Section	S T R	
	S T R	
3. Miscellaneous Property in Sec.	S T R	
	S T R	

Register of Deeds Stamp & File Number

4. Lot No. _____, Recorded Plat _____
5. Private Claims _____

Section Corner 13 & 24, T44N R35W
18 & 19, T44N R34W

I, Gary L. Pisoni, in a field survey on Oct. 17, 1995 do hereby state that under requirements of P.A. 74, Michigan P.A. of 1970, the corner points mentioned in lines 1 and 2 above were in conformance with regulations and rules therefore as required in the current manual of survey instructions of the United States Department of the Interior, Bureau of Land Management or by a decree of a Court of Law and for that the corner points mentioned in lines 3, 4 and 5 above were in conformance with the rules of the Michigan Board of Land Surveyors or by a Decree of a Court of Law, established, re-established, monumented, recovered, found as expressed below:

NOTE: Not more than 2 corners, all in the same town and range, may be recorded on this certificate.

	A	B	C	D	E	F	G	H	I	J	K	L	M
1													
2	6		5		4		3		2		1		
3													
4	7		8		9		10		11		12		
5													
6	10		17		16		15		14		13		
7													
8	19		20		21		22		23		24		
9													
10	30		29		28		27		26		25		
11													
12	31		32		33		34		35		36		
13													

A. Description of original monument and accessories and/or subsequent restoration:

Original corner established by William Burt, U.S. Deputy Surveyor on September 15, 1846.
Original corner: Yellow Birch Post
Original bearing trees:

Sugar	8"	N 36° E	37 links (24.42 feet)
Cedar	18"	S 76° W	36 links (23.76 feet)
Sugar	16"	N 44½° W	38 links (25.08 feet)
Fir	12"	S 15° E	50 links (33.00 feet)

Arthur O. Enger, RLS for M.D.N.R. on 4/29/76 recovered original cedar BT stump & White Pine line tree 8.326 ch. South and set a 1" I.D. x 36" iron pipe with a stamped 3 3/4" aluminum cap

~~B. Description of corner evidence found and/or method applied in restoring or reestablishing corner~~

and established the following bearing trees: Black Spruce 9" S 51° W 45.9 feet
Balsam 6" S 26° E 41.5 feet

B. Description of corner evidence found.


No original corner evidence found. Found original White Pine line tree, approx. 14 feet tall, South of corner position as described in original field notes and as found by Enger on 4/29/76. White Pine line tree checks real close to the original field notes and to the DNR monument set by Enger as described above.

ACT 74 Research on file with County Representative

C. Description of monument for corner and accessories established to perpetuate locating the position of the corner: COUNTY REPRESENTATIVE

From the above described aluminum cap monument, I established the following new blazed and scribed bearing trees: (all measurements taken to a nail in side of tree)

Balsam	11"	S 30° E	41.59 feet
Black Spruce	6"	S 11° W	62.58 feet
Balsam	11"	N 86° W	21.61 feet
Aspen	8"	N 40° W	28.34 feet
Steel Sign Post		North	0.65 feet

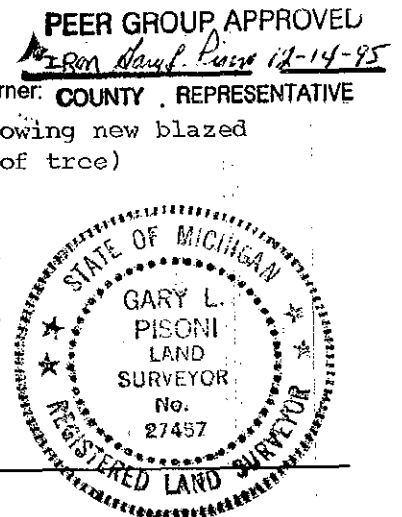

Signed by Gary L. Pisoni
Surveyor's Michigan License No. 27457

Date 11-30-95