

SURVEY & REMONUMENTATION

1993

COMMISSION

LAND CORNER RECORDATION CERTIFICATE
Filing Requirement of Act 74, Mich. P.A. 1970

IRON COUNTY
MICHIGAN
RECEIVED FOR RECORD

93 DEC 29 PM 3: 54
L.C. RECORDS. L. 6 P. 312

Gilbert Stebbins
REGISTER OF DEEDS

For corners in

Iron
(County)

Located In:

Corner Code #

- 1. Public Land Survey T 44N R 34W G-9
- T R
- T R
- T R
- 2. Property Controlling S T R
- in Section S T R
- 3. Miscellaneous S T R
- Property in Sec. S T R
- 4. Lot No. _____, Recorded Plat _____
- 5. Private Claims _____

Register of Deeds Stamp & File Number

Section Corner 21-22-27-28 T44N R34W

I, Gary L. Pisoni, in a field survey on December 20, 19 93, do hereby certify that under requirements of P.A. 74, Michigan P.A. of 1970, the corner points mentioned in lines 1 and 2 above were in conformance with regulations and rules therefore as required in the current manual of survey instructions of the United States Department of the Interior, Bureau of Land Management or by a decree of a Court of Law and/or that the corner points mentioned in lines 3, 4 and 5 above were in conformance with the rules of the Michigan Board of Land Surveyors or by a Decree of a Court of Law; established, re-established, monumented, ~~re-monumented~~, recovered, found as expressed below:

A	B	C	D	E	F	G	H	I	J	K	L	M
2	6	5	4	3	2	1						
3												
4	7	8	9	10	11	12						
5												
6	18	17	16	15	14	13						
7												
8	19	20	21	22	23	24						
9												
10	30	29	28	27	26	25						
11												
12	31	32	33	34	35	36						
13												

NOTE: Not more than 4 corners, all in the same town and range, may be recorded on this certificate.

A. Description of original monument and accessories and/or subsequent restoration:

Original corner established by Guy H. Carleton, U.S. Deputy Surveyor in 1851.

Original corner: Wood Post

Original bearing trees:

Sugar Maple	16"	S 70° E	9 links (5.94 feet)
Yellow Birch	10"	N 55° W	29 links (19.14 feet)

B. Description of corner evidence found and/or method applied in restoring or reestablishing corner:


No evidence of original corner or bearing tree remains. Aluminum capped iron pipe set by Arthur Enger RLS, M.D.N.R. on July 28, 1977 recorded in Liber 1, page 496 of Land Corner Records, was destroyed during logging construction. Reset Section corner position from a Sugar Maple bearing tree set by Art Enger RLS. Reset corner position with a 5/8"x30" rebar in July of 1993. Replaced rebar and set an aluminum pipe monument as described below. Monument is flush with ground surface.

Corner accepted as a careful and faithful re-establishment of the position of the original corner.

C. Description of monument for corner and accessories established to perpetuate locating the position of the corner:

At the corner position, I set a 2" diameter by 30" long split base aluminum pipe monument with a 3" cast aluminum cap, stamped to read: Iron County Remonumentation, T44N, R34W, S-21, S-22, S-28, S-27, 1993, RLS-27457 from which I established the following new blazed and scribed bearing trees: (all measurements taken to a nail in side of tree)

Sugar Maple (existing)	11"	N 78° W	47.30 feet
Sugar Maple (new)	3"	S 63° W	36.96 feet
Sugar Maple (new)	9"	N 12° W	38.01 feet
Steel Sign Post		North	1.50 feet

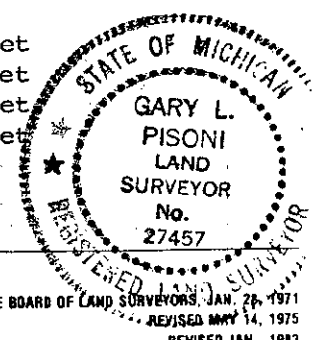

Signed by Gary L. Pisoni

Date 12-28-93

Surveyor's Michigan License No. 27457