

**SURVEY &
REMONUMENTATION**

JAN 19 1999

SECTION

**LAND CORNER RECORDATION CERTIFICATE
Filing Requirement of Act 74, Mich. P.A. 1970**

For corners in

Iron (County)	Located In:	Corner Code #
1. Public Land Survey	T <u>44N</u> R <u>34W</u>	<u>L-11</u>
	T _____ R _____	_____
	T _____ R _____	_____
	T _____ R _____	_____
2. Property Controlling in Section	S _____ T _____ R _____	_____
	S _____ T _____ R _____	_____
3. Miscellaneous Property in Sec.	S _____ T _____ R _____	_____
	S _____ T _____ R _____	_____

IRON COUNTY
MICHIGAN
RECEIVED FOR RECORD
98 DEC 28 AM 11:21
L.P. Register: L.P. 292
Gary L. Pisoni
Register of Deeds Stamp & File Number

4. Lot No. _____, Recorded Plat _____
5. Private Claims _____

Quarter Corner Sections 25 and 36, T44N, R34W

I, Gary L. Pisoni, in a field survey on Nov. 20, 1998 do hereby state that under requirements of P.A. 74, Michigan P.A. of 1970, the corner points mentioned in lines 1 and 2 above were in conformance with regulations and rules therefore as required in the current manual of survey instructions of the United States Department of the Interior, Bureau of Land Management or by a decree of a Court of Law and /or that the corner points mentioned in lines 3, 4 and 5 above were in conformance with the rules of the Michigan Board of Land Surveyors or by a Decree of a Court of Law; established, re-established, monumented, recovered, found as expressed below:

	A	B	C	D	E	F	G	H	I	J	K	L	M
1													
2		6		5		4		3		2		1	
3													
4		7		8		9		10		11		12	
5													
6		18		17		16		15		14		13	
7													
8		19		20		21		22		23		24	
9													
10		30		29		28		27		26		25	
11													
12		31		32		33		34		35		36	
13													

NOTE: Not more than 2 corners, all in the same town and range, may be recorded on this certificate.

A. Description of original monument and accessories and/or subsequent restoration:

Original corner established on Aug. 27, 1851 by Guy H. Carleton, U.S. Deputy Surveyor
Original Corner; Wood Post
Original Bearing Trees:
Sugar 12" S 15° E 105 lks (69.30 feet)
Fir 9" N 25° W 82 lks (54.12 feet)

On 8-4-77, Arthur O. Enger, RLS with Michigan Dept. of Natural Resources restored the corner position from a found 1 1/4" iron bar. He accepted the iron bar as the best available evidence for restoring the corner position, recorded in L.C. Certificate, Liber 1, Page 563 on 8/25/78.

1977 Bearing Trees:
White Spruce 16" S 4° E 71.2 feet
Elm 12" N 42° E 62.2 feet

B. Description of corner evidence found and/or method applied in restoring or reestablishing corner:

No evidence of original B.T.s found.

Found iron bar as described above. No evidence of above described bearing trees. I accept the iron bar as the best available evidence for restoring the corner position.

PEER REVIEW APPROVED
Don L. Pisoni 12-18-98
COUNTY REPRESENTATIVE

Corner record research on file with County Representative.

C. Description of monument for corner and accessories established to perpetuate locating the position of the corner:

Replaced iron bar with a 2" diameter by 30" long split base aluminum pipe monument with a 3" aluminum cap stamped to read: Iron County Remonumentation, T44N, R34W, 1/4, S-25, S-36, 1998, RLS 27457 from which I established the following new blazed and scribed bearing trees: (All measurements taken to a nail in side of tree)

Balsam	4"	N 76° W	38.05 feet
Black Cherry	9"	N 25° W	59.56 feet
Balsam	3"	N 73° E	4.12 feet
Steel sign post		N 25° W	0.80 feet


98-136

Signed by *Gary L. Pisoni*

Date 12-21-98

Surveyor's Michigan License No. 27457

FORM APPROVED BY MICHIGAN STATE BOARD OF PROFESSIONAL SURVEYORS, JAN. 28, 1971
No. 27457 REVISOR: MAY 24, 1975
REVISOR: JAN 1983
REVISOR: OCT 1995

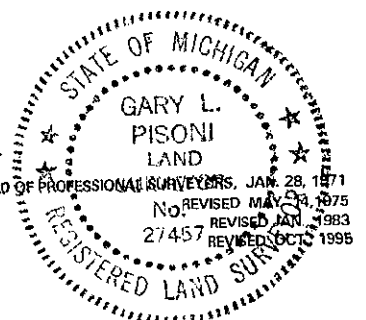

L.7 P. 292