

LAND CORNER RECORDATION CERTIFICATE
Filing Requirement of Act 74, Mich. P.A. 1970

For corners in

<u>Iron</u>	Located In:	Corner Code #	
(County)			
1. Public Land Survey	T <u>44N</u> R <u>34W</u>	<u>MC south of I4</u>	
	T _____ R _____	_____	
	T _____ R _____	_____	
	T _____ R _____	_____	
2. Property Controlling in Section	S <u>11</u> T <u>44N</u> R <u>34W</u>	<u>8</u>	
	S _____ T _____ R _____	_____	
3. Miscellaneous Property in Sec.	S _____ T _____ R _____	_____	
	S _____ T _____ R _____	_____	

Register of Deeds Stamp & File Number

4. Lot No. _____, Recorded Plat _____
 5. Private Claims _____

8 Mar 20 2003
 MC Mar 19 2003

I, Stephan J. Szyszkoski, in a field survey on _____, 20____ do hereby state that under requirements of P.A. 74, Michigan P.A. of 1970, the corner points mentioned in lines 1 and 2 above were in conformance with regulations and rules therefore as required in the current manual of survey instructions of the United States Department of the Interior, Bureau of Land Management or by a decree of a Court of Law and /or that the corner points mentioned in lines 3, 4 and 5 above were in conformance with the rules of the Michigan Board of Land Surveyors or by a Decree of a Court of Law; established, re-established, monumented, recovered, found as expressed below:

	A	B	C	D	E	F	G	H	I	J	K	L	M
1													
2		6		5		4		3		2		1	
3													
4		7		8		9		10	●	11		12	
5													
6		18		17		16		15		14		13	
7													
8		19		20		21		22		23		24	
9													
10		30		29		28		27		26		25	
11													
12		31		32		33		34		35		36	
13													


NOTE: Not more than 2 corners, all in the same town and range, may be recorded on this certificate.

A. Description of original monument and accessories and/or subsequent restoration:
 (MC south of I4) Meander corner on north bank of the Paint River between Sections 10 and 11. 1851: Established by Guy Carleton. S19'W corrected between Secs. 10 & 11...46.36 intersect left bank of River and set meander post. Fir 12 N85W 12 links, Fir 6 N25E 58 links...49.86 Over River to right bank and set meander post.
 (8-Sec. 11) West 1/16 corner, Section 11. Not established in the original survey. Found no subsequent record.

B. Description of corner evidence found and/or method applied in restoring or reestablishing corner:
 (MC south of I4) The original post and accessories were not recovered. Reestablished the corner by single proportionate measurement to the original record between perpetuated original positions 3034.56' north (Sec. corner) and 258.14' south (MC on south bank of river). The position for this corner now falls in the Paint River. Established a Witness Corner to the MC, on the Section line, on the north bank of the Paint River, 27.00 feet north of the position of the reestablished Meander Corner.
 (8-Sec. 11) Established the corner midway and on a straight line between Quarter corner 1312.21' west and Center of Section 1312.21' east. The corner position falls in the Paint River and was not monumented. Established and monumented a Witness Corner to the 1/16 corner position, on the N-S 1/16 line, 57.90' North of the West 1/16 corner.

C. Description of monument for corner and accessories established to perpetuate locating the position of the corner:

(MC) Set 1"IDx32" I. pipe with 4" MDNR cap 27.00' north of the MC position and on the Section line. Blazed, scribed, and set measuring nails in: 12" Y. Birch N12E 54.5' "MC BT" 6" Maple in clump S71E 22.1' do 4" Maple in clump S78W 22.5' do 9" Y. Birch N68W 56.2' do Set squared post adjacent. Bearings are magnetic. Distances are to nail with plastic tag.	(8) Set 1"IDx32" I. pipe with 4" alum. MDNR cap 57.90' North of the 1/16 cor. Blazed, scribed, and set meas. nails in: 10" Spruce N32E 26.60' "MC BT" 5" Maple in clump S78W 21.30' do 5" Balsam N42W 25.50' do 10" Cherry N28W 37.20' do Squared cedar post adjacent. Bearings are magnetic. Distances are to nail with plastic tag.
---	--

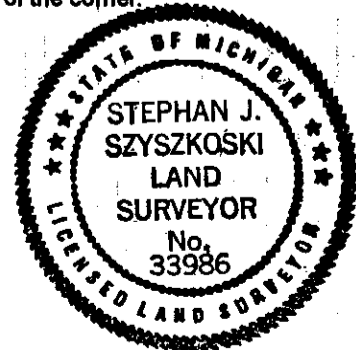

Signed by Stephan J. Szyszkoski
 Surveyor's Michigan License No. 33986

Date 6/10/03