

LAND CORNER RECORDATION CERTIFICATE
Filing Requirement of Act 74, Mich. P.A. 1970

For corners in

Iron _____ (County)	Located In:	Corner Code #	
1. Public Land Survey	T 44N R 34N	J4	_____
	T _____ R _____	_____	_____
	T _____ R _____	_____	_____
	T _____ R _____	_____	_____
2. Property Controlling in Section	S 11 T 44N R 34N	4	_____
	S _____ T _____ R _____	_____	_____
3. Miscellaneous Property in Sec.	S _____ T _____ R _____	_____	_____
	S _____ T _____ R _____	_____	_____

Register of Deeds Stamp & File Number

4. Lot No. _____, Recorded Plat _____
 5. Private Claims _____

Mar 20 2003

I, Stephan J. Szyszkoski, in a field survey on _____, 20____ do hereby state that under requirements of P.A. 74, Michigan P.A. of 1970, the corner points mentioned in lines 1 and 2 above were in conformance with regulations and rules therefore as required in the current manual of survey instructions of the United States Department of the Interior, Bureau of Land Management or by a decree of a Court of Law and /or that the corner points mentioned in lines 3, 4 and 5 above were in conformance with the rules of the Michigan Board of Land Surveyors or by a Decree of a Court of Law, established, re-established, monumented, recovered, found as expressed below:

NOTE: Not more than 2 corners, all in the same town and range, may be recorded on this certificate.


1	A	B	C	D	E	F	G	H	I	J	K	L	M
2		6		5		4		3		2		1	
3													
4		7		8		9		10		11		12	
5													
6		18		17		16		15		14		13	
7													
8		19		20		21		22		23		24	
9													
10		30		29		28		27		26		25	
11													
12		31		32		33		34		35		36	
13													

A. Description of original monument and accessories and/or subsequent restoration:
 (J4) Center of Section 11. Not established in the original survey. Found no subsequent record.
 (4-Sec. 11) Northwest 1/16 corner, Section 11. Not established in the original survey. Found no subsequent record.

B. Description of corner evidence found and/or method applied in restoring or reestablishing corner:
 (J4) Established the corner at the intersection of straight lines connecting opposite 1/4 corners.
 (4-Sec. 11) Established the corner at the intersection of straight lines connecting opposite 1/16 corners.

C. Description of monument for corner and accessories established to perpetuate locating the position of the corner:

(J4) Set 1"IDx32" I. pipe with 4" alum. MDNR cap. Blazed, scribed and set measuring nails in: 10" Cherry N62E 51.9' "C1/4 BT" 4" Balsam S87E 6.5' do 5" Balsam N54W 24.3' do 16" Spruce N15W 55.2' do Set squared cedar post adjacent. Bearings are magnetic. Distances are to nail with plastic tag.	(4) Set 1"IDx32" I. pipe with 4" alum. MDNR cap. Blazed and scribed: 5" Balsam N29E 24.55' "1/16S BT" 3" Balsam S76E 31.75' do 7" Poplar S43W 32.40' do 3" Poplar N23W 21.00' do Set squared post adjacent. Bearings are magnetic. Distances are to nail with plastic tag.
---	---

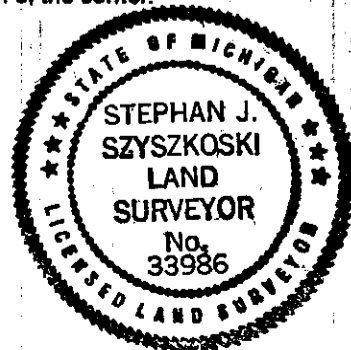

Signed by Stephan J. Szyszkoski
 Surveyor's Michigan License No. 33986

Date 6/10/03