

# SURVEY & REMONUMENTATION

JAN 19 1999

## SECTION

### LAND CORNER RECORDATION CERTIFICATE Filing Requirement of Act 74, Mich. P.A. 1970

For corners in

<u>Iron</u> (County)	Located in:	Corner Code #
1. Public Land Survey	T <u>44N</u> R <u>35W</u>	<u>E-3</u>
	T _____ R _____	_____
	T _____ R _____	_____
	T _____ R _____	_____
2. Property Controlling in Section	S _____ T _____ R _____	_____
	S _____ T _____ R _____	_____
3. Miscellaneous Property in Sec.	S _____ T _____ R _____	_____
	S _____ T _____ R _____	_____

IRON COUNTY  
MICHIGAN  
RECEIVED FOR RECORD

98 DEC 28 AM 11:19  
*L.C. Records: L. 7, P. 282*  
*Graham Stiles*

Register of Deeds Stamp & File Number

4. Lot No. \_\_\_\_\_, Recorded Plat \_\_\_\_\_  
5. Private Claims \_\_\_\_\_

Section Corner Sections 4, 5, 8 and 9, T44N, R35W

I, Gary L. Pisoni, in a field survey on Dec. 1, 1998 do hereby state that under requirements of P.A. 74, Michigan P.A. of 1970, the corner points mentioned in lines 1 and 2 above were in conformance with regulations and rules therefore as required in the current manual of survey instructions of the United States Department of the Interior, Bureau of Land Management or by a decree of a Court of Law and /or that the corner points mentioned in lines 3, 4 and 5 above were in conformance with the rules of the Michigan Board of Land Surveyors or by a Decree of a Court of Law; established, re-established, monumented, recovered, found as expressed below:

	A	B	C	D	E	F	G	H	I	J	K	L	M
1													
2		6		5		4		3		2		1	
3					●								
4		7		8		9		10		11		12	
5													
6		18		17		16		15		14		13	
7													
8		19		20		21		22		23		24	
9													
10		30		29		28		27		26		25	
11													
12		31		32		33		34		35		36	
13													

**NOTE:** Not more than 2 corners, all in the same town and range, may be recorded on this certificate.

**A. Description of original monument and accessories and/or subsequent restoration:**

Original corner established in September, 1851 by Harvey Mellen, Deputy Surveyor.  
Original Corner; Wood Post  
Original Bearing Trees:  
White Pine 20" N 63° W 25 lks (16.50 feet)  
White Pine 24" S 56° E 25 lks (16.50 feet)

On 9/13/68, Donald D. Lappala, RLS U.S.F.S., restored the corner position from a found iron pipe embedded in concrete marking corner position, replaced iron pipe and set a 2" diameter by 5' long galvanized iron pipe with a 3" brass cap stamped as follows: T44N, R35W, S-4, S-5, S-8, S-9, RLS 12585, 1968, 12" above ground surface recorded in L.C. Certificate Liber 3, Page 22 on 3/31/69.

1968 Bearing Trees:  
Wood sign post N 32° W 3.6 feet  
SE corner of school foundation N 80° E 15.3 feet  
WMPC Pole #2661 S 13° E 57.6 feet  
MI Bell cable marker S 70° W 90.1 feet

PEER GROUP APPROVED  
*Iron Pipe 12-18-98*  
COUNTY REPRESENTATIVE

**B. Description of corner evidence found and/or method applied in restoring or reestablishing corner:**


No evidence of original B.T.s found. Found monument as described above and the following bearing objects:  
White Pine 10" N 11° W 43.64 feet  
Wood sign post N 37° W 3.65 feet

I accept the above monument as the best available evidence for restoring the corner position.

Corner record research on file with County Representative.

**C. Description of monument for corner and accessories established to perpetuate locating the position of the corner:**

The following new corner references:  
Rebar 5/8" x 30" N 85° E 10.28 feet  
Utility Pole 74-0578 S 16° E 55.90 feet  
Steel sign post N 32° E 1.35 feet

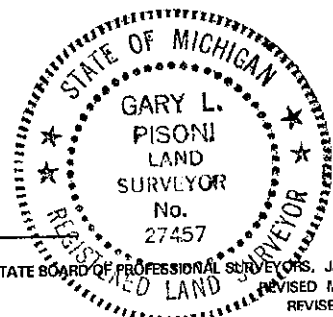

98-123  
Signed by Gary L. Pisoni Date 12-21-98  
Surveyor's Michigan License No. 27457

*L. 7 P. 282*