

SURVEY & REMONUMENTATION

1993

COMMISSION

LAND CORNER RECORDATION CERTIFICATE
Filing Requirement of Act 74, Mich. P.A. 1970

IRON COUNTY MICHIGAN
RECEIVED FOR RECORD

93 DEC 29 PH 2:18
L.C. RECORDS L. C. P. 271

Eileen J. Stiles
REGISTER OF DEEDS

For corners in


Iron (County)	Located In:	Corner Code #
1. Public Land Survey	T <u>44N</u> R <u>35W</u>	<u>E-4</u>
	T _____ R _____	_____
	T _____ R _____	_____
	T _____ R _____	_____
2. Property Controlling in Section	S _____ T _____ R _____	_____
	S _____ T _____ R _____	_____
3. Miscellaneous Property in Sec.	S _____ T _____ R _____	_____
	S _____ T _____ R _____	_____

Register of Deeds Stamp & File Number

4. Lot No. _____, Recorded Plat _____
5. Private Claims _____

Quarter Corner 8-9 T44N R35W

I, Gary L. Pisoni, in a field survey on December 16, 1993 do hereby certify that under requirements of P.A. 74, Michigan P.A. of 1970, the corner points mentioned in lines 1 and 2 above were in conformance with regulations and rules therefore as required in the current manual of survey instructions of the United States Department of the Interior, Bureau of Land Management or by a decree of a Court of Law and/or that the corner points mentioned in lines 3, 4 and 5 above were in conformance with the rules of the Michigan Board of Land Surveyors or by a Decree of a Court of Law; established, re-established, monumented, re-monumented, recovered, found as expressed below:

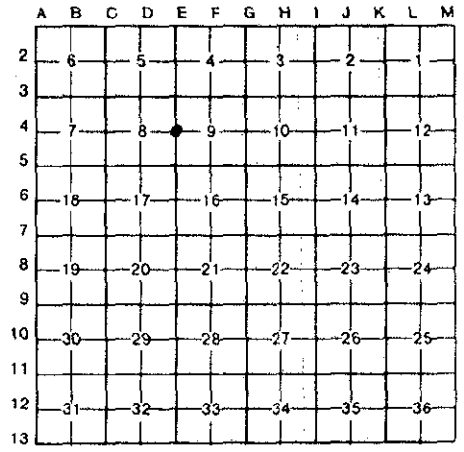

NOTE: Not more than 4 corners, all in the same town and range, may be recorded on this certificate.

A. Description of original monument and accessories and/or subsequent restoration:

Original corner established by Harvey Mellen, U.S. Deputy Surveyor in 1851.
Original corner: Wood Post
Original bearing trees:

Tamarack	10"	S 30° E	10 links (6.60 feet)
Spruce	10"	S 43° W	24 links (15.84 feet)


B. Description of corner evidence found and/or method applied in restoring or reestablishing corner:

No evidence of original corner or bearing tree remains. Corner position was re-established by the U.S. Forest Service on September 13, 1968 as recorded in Liber 3, page 29 of Land Corner Certificates. Found brass capped iron pipe as described in above recorded certificate. Said monument was bent over and replaced with an aluminum pipe monument as described below. Monument located on East side of Gibbs City Road. Monument is 3" above ground surface.

C. Description of monument for corner and accessories established to perpetuate locating the position of the corner:

At the corner position, I set a 2" diameter by 30" long split base aluminum pipe monument with a 3" cast aluminum cap, stamped to read: Iron County Remonumentation, T44N, R35W, 1/4, S-8, S-9, 1993, R.L.S. 27457; from which I established the following new blazed and scribed bearing trees: (all measurements taken to a nail in side of tree)

Black Cherry	11" dbl	N 53° E	19.63 feet
Rebar	5/8"x30"	S 50° E	10.21 feet
Jack Pine	7"	S 06° E	56.07 feet
Jack Pine	8"	N 41° W	82.10 feet
Steel rail		East	1.30 feet

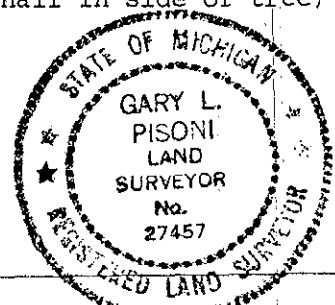

Signed by Gary L. Pisoni
Surveyor's Michigan License No. 27457

Date 12-28-93