

SURVEY & REMONUMENTATION

JAN 19 1999

SECTION

LAND CORNER RECORDATION CERTIFICATE
Filing Requirement of Act 74, Mich. P.A. 1970

For corners in

Iron <small>(County)</small>	Located In:	Corner Code #
1. Public Land Survey	T <u>44N</u> R <u>R35W</u>	<u>E-12</u>
	T _____ R _____	_____
	T _____ R _____	_____
	T _____ R _____	_____
2. Property Controlling in Section	S _____ T _____ R _____	_____
	S _____ T _____ R _____	_____
3. Miscellaneous Property in Sec.	S _____ T _____ R _____	_____
	S _____ T _____ R _____	_____

IRON COUNTY
MICHIGAN
RECEIVED FOR RECORD
98 DEC 28 AM 11:20
L.C. Records L. 7, P. 287
[Signature]
Register of Deeds Stamp & File Number

4. Lot No. _____, Recorded Plat _____
 5. Private Claims _____

Quarter Corner Sections 32 and 33, T44N, R35W

I, Gary L. Pisoni, in a field survey on Dec. 1, 1998, do hereby state that under requirements of P.A. 74, Michigan P.A. of 1970, the corner points mentioned in lines 1 and 2 above were in conformance with regulations and rules therefore as required in the current manual of survey instructions of the United States Department of the Interior, Bureau of Land Management or by a decree of a Court of Law and /or that the corner points mentioned in lines 3, 4 and 5 above were in conformance with the rules of the Michigan Board of Land Surveyors or by a Decree of a Court of Law; established, re-established, monumented, recovered, found as expressed below:

	A	B	C	D	E	F	G	H	I	J	K	L	M
1													
2		6		5		4		3		2		1	
3													
4		7		8		9		10		11		12	
5													
6		18		17		16		15		14		13	
7													
8		19		20		21		22		23		24	
9													
10		30		29		28		27		26		25	
11													
12		31		32		33		34		35		36	
13													

NOTE: Not more than 2 corners, all in the same town and range, may be recorded on this certificate.

A. Description of original monument and accessories and/or subsequent restoration:

Original corner established in Sept., 1851 by Harvey Mellen, Deputy Surveyor.
 Original Corner; Wood Post
 Original Bearing Trees:

Sugar	8"	N 75° W	16 lks (10.56 feet)
Maple	12"	N 10° E	29 lks (19.14 feet)

On 8/11/67, Donald D. Lappala RLS U.S. Forest Service found at the corner position a 1" diameter iron pin in the centerline of Gibbs City Road which runs North and South and in line with an East/West fence line, said iron pin was set by I.N. Woodworth RLS in the 1940's. Lappala set a reference monument being a 2" diameter by 5' long galvanized iron pipe with a 3" brass cap stamped as follows: T44N, R35W, R.M., 1/4, S-32, S-33, East 29.06 feet, RLS 12585, 1967, 24" above ground surface recorded in L.C. Certificate Liber 3, Page 74 on 5/3/68.

1967 Bearing Tree:

Elm	14"	N 30° E	67.6 feet
WI/MI Power Pole #1256		S 18° W	95.5 feet

P.E.B. APPROVED
Iron St. L. 7-18-98
 COUNTY REPRESENTATIVE

B. Description of corner evidence found and/or method applied in restoring or reestablishing corner:

No evidence of original B.T.s found. Found monument as described above, but the above Reference Monument found lying on its side.

I accept the above monument as the best available evidence for restoring the corner position.

Corner record research on file with County Representative.

C. Description of monument for corner and accessories established to perpetuate locating the position of the corner:
 Reference monument being a 5/8" diameter by 30" long rebar with a 3" aluminum cap stamped as follows: T44N, R35W, R.M. 1/4, S-32, S-33, East, 26.33', 1998, RLS 27457. From the quarter corner position, I blazed and scribed the following new bearing tree: (All measurements taken to a nail in side of tree)

R.M.	5/8" x 30" Rebar	West	26.33 feet
Sugar Maple	13"	N 17° E	81.35 feet
Balsam	8"	S 83° E	72.04 feet
Utility Pole #88-21495		S 18° W	97.70 feet
Steel sign post		West	26.90 feet


98-128

Signed by *Gary L. Pisoni*

Date 12-21-98

Surveyor's Michigan License No. 27457

FORM APPROVED BY MICHIGAN STATE BOARD OF PROFESSIONAL SURVEYORS, JAN. 28, 1971
 REVISED MAY 14, 1975
 REVISED JAN. 1983
 REVISED OCT. 1995

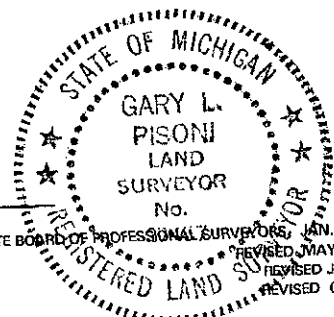

L. 7 P. 287