

**SURVEY &
REMONUMENTATION**

JAN 19 1999

SECTION

**LAND CORNER RECORDATION CERTIFICATE
Filing Requirement of Act 74, Mich. P.A. 1970**

For corners in

<u>Iron</u> (County)	Located In:	Corner Code #
1. Public Land Survey	T <u>44N</u> R <u>35W</u>	<u>F-3</u>
	T _____ R _____	_____
	T _____ R _____	_____
	T _____ R _____	_____
2. Property Controlling in Section	S _____ T _____ R _____	_____
	S _____ T _____ R _____	_____
3. Miscellaneous Property in Sec.	S _____ T _____ R _____	_____
	S _____ T _____ R _____	_____

IRON COUNTY
MICHIGAN
RECEIVED FOR RECORD
98 DEC 28 AM 11:21
L.C. Records: L.7, P.294
Gary L. Pisoni

Register of Deeds Stamp & File Number

4. Lot No. _____, Recorded Plat _____
5. Private Claims _____

Quarter Corner Sections 4 and 9, T44N, R35W

I, Gary L. Pisoni, in a field survey on Dec. 1, 1998 do hereby state that under requirements of P.A. 74, Michigan P.A. of 1970, the corner points mentioned in lines 1 and 2 above were in conformance with regulations and rules therefore as required in the current manual of survey instructions of the United States Department of the Interior, Bureau of Land Management or by a decree of a Court of Law and /or that the corner points mentioned in lines 3, 4 and 5 above were in conformance with the rules of the Michigan Board of Land Surveyors or by a Decree of a Court of Law; established, re-established, monumented, recovered, found as expressed below:

1	A	B	C	D	E	F	G	H	I	J	K	L	M
2		6		5		4		3		2		1	
3						●							
4		7		8		9		10		11		12	
5													
6		18		17		16		15		14		13	
7													
8		19		20		21		22		23		24	
9													
10		30		29		28		27		26		25	
11													
12		31		32		33		34		35		36	
13													

NOTE: Not more than 2 corners, all in the same town and range, may be recorded on this certificate.

A. Description of original monument and accessories and/or subsequent restoration:

Original corner established in Sept., 1851 by Harvey Mellen, Deputy Surveyor.
Original Corner; Wood Post
Original Bearing Trees:
White Pine 20" S 80° E 6 lks (3.96 feet)
White Pine 30" N 23° W 12 lks (7.92 feet)

On 6/27/72, Donald D. Lappala, RLS U.S.F.S., restored the corner position at record bearing and distance from the stump remains of the two original bearing trees. He set a 2" diameter by 5' long galvanized iron pipe with a 3" brass cap stamped as follows: T44N, R35W, 1/4, S-4, S-9, RLS 12585, 1972, 24" above ground surface recorded in L.C. Certificate Liber 3, Page 23 on 2/27/75.

1972 Bearing Trees:
White Spruce 12" N 50° E 166.5 feet
Iron Pin 1" x 36" East 60.0 feet
Metal sign post N 30° E 2.5 feet

REC'D
Gary L. Pisoni 12-18-98
COUNTY REPRESENTATIVE

B. Description of corner evidence found and/or method applied in restoring or reestablishing corner:

No evidence of B.T.s found. Found monument as described above and the following bearing tree:
Spruce 18" N 49° E 166.57 feet
Iron Pin 1" x 36" East 60.0 feet
Metal sign post N 30° E 2.5 feet

I accept the above monument as the best available evidence for restoring the corner position.

Corner record research on file with County Representative.

C. Description of monument for corner and accessories established to perpetuate locating the position of the corner:


Blazed and scribed the following new bearing trees: (All measurements taken to a nail in side of tree)

Jack Pine	7"	N 49° W	136.89 feet
Rebar	5/8" x 30"	East	20.02 feet
Rebar	5/8" x 30"	S 24° W	19.04 feet
Steel sign post		S 34° E	1.55 feet

98-142
Signed by Gary L. Pisoni Date 12-21-98

Surveyor's Michigan License No. 27457

FORM APPROVED BY MICHIGAN STATE BOARD OF PROFESSIONAL SURVEYORS, JAN. 30, 1971
REVISED MAY 14, 1975
REVISED JAN. 1983
REVISED OCT., 1995

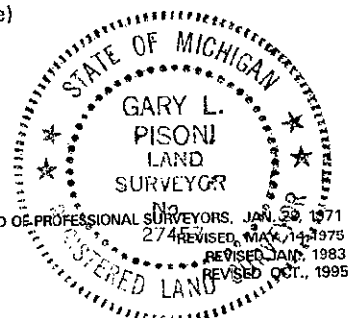

L.7 P.294