

FEB 23 1996

LAND CORNER RECORDATION CERTIFICATE

Filing Requirement of Act 74, Mich. P.A. 1970

For corners in

Iron (County)

Located In:

Corner Code #

- 1. Public Land Survey T 43N R 35W T 44N R 35W
2. Property Controlling in Section S T R
3. Miscellaneous Property in Sec. S T R

I-1 I-13


REGISTERS OFFICE ) ..SS IRON COUNTY, MICH. ) ..SS RECEIVED FOR RECORD THE 21st DAY OF FEBRUARY A.D. 19 95 AT 2:45 O'CLOCK P.M. AND RECORDED IN LIBER 6 OF L.C. RECORDS ON PAGE 356

Register of Deeds Stamp & File Number

- 4. Lot No. , Recorded Plat
5. Private Claims

Section Corner 34, 35, 3, 2, T44N, T43N, R35W

I, Gary L. Pisoni, in a field survey on September 13, 1994 do hereby certify that under requirements of P.A. 74, Michigan P.A. of 1970, the corner points mentioned in lines 1 and 2 above were in conformance with regulations and rules therefore as required in the current manual of survey instructions of the United States Department of the Interior, Bureau of Land Management or by a decree of a Court of Law and/or that the corner points mentioned in lines 3, 4 and 5 above were in conformance with the rules of the Michigan Board of Land Surveyors or by a Decree of a Court of Law; established, re-established, monumented, re-monumented, recovered, found as expressed below:

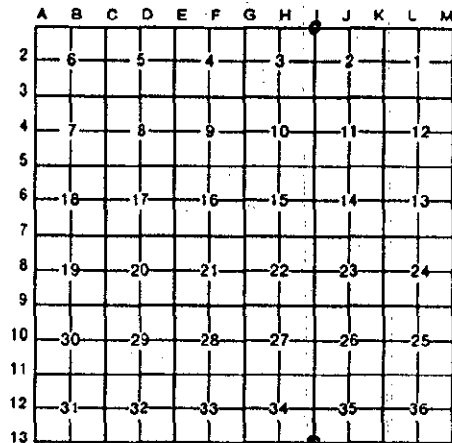

NOTE: Not more than 4 corners, all in the same town and range, may be recorded on this certificate.

A. Description of original monument and accessories and/or subsequent restoration:

Original corner established by William A. Burt, U.S. Deputy Surveyor in 1847. Original corner: Wood Post Original bearing trees: Yellow Birch 7" N 27° E 53 links (34.98 feet) Yellow Birch 16" N 60° W 35 links (23.10 feet) Original corner recovered by Harvey Mellen, U.S. Deputy Surveyor in 1851. Original bearing trees: Yellow Birch 8" S 49° E 10 links (6.60 feet) Yellow Birch 14" S 28° W 43 links (28.38 feet)

B. Description of corner evidence found and/or method applied in restoring or reestablishing corner:

No evidence of original corner or bearing tree remains. Corner position found marked by a 5/8" x 17" rebar, set by Gerald W. Carlson RLS #24589 from a section sub-division of Section 3. Corner position found at the intersection of an old fence corner. Set an aluminum pipe monument over the top of rebar pin as described below. Monument is 3" above ground surface.

This corner is accepted as the best available evidence of the position of the original corner.

County Record Research on file with County Representative Office.

PEER GROUP APPROVED Gary L. Pisoni COUNTY REPRESENTATIVE

C. Description of monument for corner and accessories established to perpetuate locating the position of the corner:

At the corner position, I set a 2" diameter by 30" long split base aluminum pipe monument with a 3" cast aluminum cap, stamped to read: Iron County Remonumentation, T44N, R35W, S-34, S-35, S-3, S-2, T43N, 1994, RLS- 27457 from which I established the following new blazed and scribed bearing trees: (all measurements taken to a nail in side of tree)

(Existing) Sugar Maple 6" N 34° W 22.55 feet Sugar Maple 5" Db1. N 68° W 1.85 feet Sugar Maple 8" S 09° W 9.55 feet Red Maple 7" Db1. N 85° E 30.00 feet Steel Sign Post N 15° E 1.10 feet



Signed by Gary L. Pisoni Date 1-9-95

Surveyor's Michigan License No. 27457