SURVEY & REMONUMENTATION

JAN 1 2 1996

COMMISSION

IRON COUNTY MICHIGAN
RECEIVED FOR RECORD
95 DEC 15 PM 2:22
LC Records L.6, P.417
Eileen Stelter
REGISTER OF DEEDS

LAND CORNER RECORDATION CERTIFICATE

Filing Requirement of Act 74, Mich. P.A. 1970

For corners in

Iron (County)

	Located In:	Corner Code #
1. Public Land Survey	T 44N R 35W	L-13
	T 43N R 35W	L-1
	T ___ R ___	
	T ___ R ___	
2. Property Controlling	S ___ T ___ R ___	
in Section	S ___ T ___ R ___	
3. Miscellaneous	S ___ T ___ R ___	
Property in Sec.	S ___ T ___ R ___	

Register of Deeds Stamp & File Number

4. Lot No. _____, Recorded Plat _____
5. Private Claims _____

Quarter Corner T44-43N, R35W

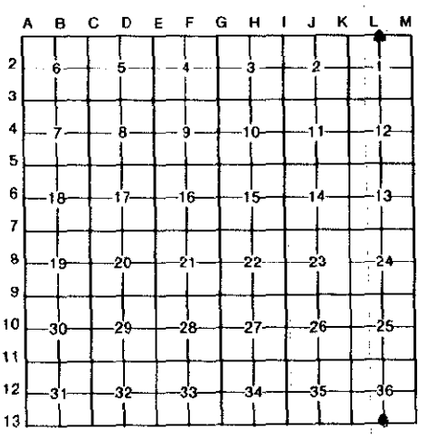

I, Gary L. Pisoni, in a field survey on October 13, 19 95, do hereby certify that under requirements of P.A. 74, Michigan P.A. of 1970, the corner points mentioned in lines 1 and 2 above were in conformance with regulations and rules therefore as required in the current manual of survey instructions of the United States Department of the Interior, Bureau of Land Management or by a decree of a Court of Law and/or that the corner points mentioned in lines 3, 4 and 5 above were in conformance with the rules of the Michigan Board of Land Surveyors or by a Decree of a Court of Law; established, re-established, monumented, re-monumented, recovered, found as expressed below:

NOTE: Not more than 4 corners, all in the same town and range, may be recorded on this certificate.

A. Description of original monument and accessories and/or subsequent restoration:

Original corner established by William A. Burt, U.S. Deputy Surveyor in 1847.
Original corner: Cedar Post
Original bearing trees:

Hemlock	16"	N 15°E	17 links (11.22 feet)
Yellow Birch	16"	N 77°W	9 links (5.94 feet)

B. Description of corner evidence found and/or method applied in restoring or reestablishing corner:

No original corner evidence found. Corner restored by single proportionate measurement methods on line between the Northwest corner of Section 1, T43N R35W and the Northeast corner of Section 1, T43N R35W. GLO distance and bearing along town line check good. Section line crosses South edge of Morrison Lake as described in original GLO field notes. Quarter corner is 33 feet East of centerline of an existing North South county gravel road.

PEER GROUP APPROVED
Iron Gary L. Pisoni 12-14-95
COUNTY REPRESENTATIVE

Research on file with County Representative.

C. Description of monument for corner and accessories established to perpetuate locating the position of the corner:

At the corner position, I set a 2" diameter by 30" long split base aluminum pipe monument with a 3" cast aluminum cap, stamped to read: Iron County Remonumentation, T44N, R35W, 1/4, S-36, S-1, T43N, 1995, RLS- 27457 from which I established the following new blazed and scribed bearing trees: (all measurments taken to a nail in side of tree)

Black Spruce	5"	N 34°W	15.10 feet
Aspen	6"	N 05°E	12.22 feet
Red Maple	7"	S 46°E	34.93 feet
Balsam	7"	S 03°E	3.69 feet
Centerline Co. Rd.		West	33.00 feet
Steel Sign Post		East	0.84 feet

STATE OF MICHIGAN
GARY L. PISONI
LAND SURVEYOR
No. 27457
REGISTERED LAND SURVEYOR

Signed by Gary L. Pisoni Date 11-30-95

Surveyor's Michigan License No. 27457

FORM APPROVED BY MICHIGAN STATE BOARD OF LAND SURVEYORS, JAN. 28, 1971
REVISED MAY 14, 1975
REVISED JAN., 1983

L.6. Page 417