

**SURVEY & REMONUMENTATION**

JAN 19 1999

**SECTION**

**LAND CORNER RECORDATION CERTIFICATE**  
**Filing Requirement of Act 74, Mich. P.A. 1970**

For corners in

Iron <small>(County)</small>	Located In:	Corner Code #
1. Public Land Survey	T <u>44N</u> R <u>36W</u>	<u>L-3</u>
	T _____ R _____	_____
	T _____ R _____	_____
	T _____ R _____	_____
2. Property Controlling in Section	S _____ T _____ R _____	_____
	S _____ T _____ R _____	_____
3. Miscellaneous Property in Sec.	S _____ T _____ R _____	_____
	S _____ T _____ R _____	_____

IRON COUNTY  
MICHIGAN  
RECEIVED FOR RECORD

98 DEC 28 AM 11:21  
L.C. Records: L. 7, P. 291

*Gilbert Stebbins*  
REGISTERED LAND SURVEYOR

Register of Deeds Stamp & File Number

4. Lot No. \_\_\_\_\_, Recorded Plat \_\_\_\_\_  
 5. Private Claims \_\_\_\_\_

Quarter Corner Sections 1 and 12, T44N, R36W

I, Gary L. Pisoni, in a field survey on Nov. 18, 1998, do hereby state that under requirements of P.A. 74, Michigan P.A. of 1970, the corner points mentioned in lines 1 and 2 above were in conformance with regulations and rules therefore as required in the current manual of survey instructions of the United States Department of the Interior, Bureau of Land Management or by a decree of a Court of Law and /or that the corner points mentioned in lines 3, 4 and 5 above were in conformance with the rules of the Michigan Board of Land Surveyors or by a Decree of a Court of Law; established, re-established, monumented, recovered, found as expressed below:

	A	B	C	D	E	F	G	H	I	J	K	L	M
1													
2		6		5		4		3		2		1	
3												●	
4		7		8		9		10		11		12	
5													
6		18		17		16		15		14		13	
7													
8		19		20		21		22		23		24	
9													
10		30		29		28		27		26		25	
11													
12		31		32		33		34		35		36	
13													

**NOTE:** Not more than 2 corners, all in the same town and range, may be recorded on this certificate.

**A. Description of original monument and accessories and/or subsequent restoration:**

Original corner established on June 26, 1851 by Martin M. Hall, U.S. Deputy Surveyor.  
 Original Corner; Maple Post  
 Original Bearing Trees:

Cedar	10"	N 38° E	19 links (12.54 feet)
Maple	12"	S 52° W	8 links (5.28 feet)

On 12/19/85, Gary L. Pisoni, RLS restored the corner position by single proportionate measurement methods on line between the Northeast corner and the Northwest corner of Section 12. Corner position is marked by a 2 1/2" diameter by 30" long aluminum pipe monument, 2" above ground surface with a 3" aluminum cap stamped as follows: T44N, R36W, 1/4, S-1, S-12, 1985, RLS 27457. Recorded in L.C. certificate Liber 5, Page 231 on 3/21/86.

1985 Bearing Trees:

Black Spruce	8"	N 86° E	22.90 feet
Tamarack	9"	S 33° W	22.56 feet
Tamarack	9"	N 35° W	6.27 feet
Steel sign post		S 89° W	2.00 feet

PEER SIGNATURE APPROVED  
*Gary L. Pisoni 12-18-98*  
 COUNTY REPRESENTATIVE

**B. Description of corner evidence found and/or method applied in restoring or reestablishing corner:**

No evidence of original B.T.s found. Found monument as described above and the following bearing trees:

Black Spruce	10"	N 86° E	22.84 feet
Tamarack	11"	S 33° W	22.58 feet
Tamarack	12"	N 35° W	6.27 feet
Steel sign post		S 89° W	2.00 feet


I accept the above monument as the best available evidence for restoring the corner position.

Corner record research on file with County Representative.

**C. Description of monument for corner and accessories established to perpetuate locating the position of the corner:**

98-134  
 Signed by *Gary L. Pisoni* Date 12-21-98  
 Surveyor's Michigan License No. 27457

FORM APPROVED BY MICHIGAN STATE BOARD OF PROFESSIONAL SURVEYORS, JAN 28, 1975  
 REVISED MAY 14, 1975  
 REVISED JAN 1983  
 REVISED OCT 1995

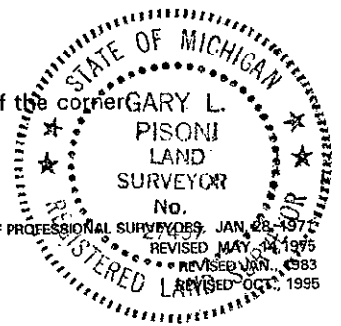

L. 7 P. 291