

FEB 2 8 1996

COMMISSION

LAND CORNER RECORDATION CERTIFICATE

Filing Requirement of Act 74, Mich. P.A. 1970

For corners in

Iron (County)

Located in:

Corner Code #

1. Public Land Survey

T 44N R 37W

L-13

T 43N R 37W

L-1

2. Property Controlling in Section

S T R

S T R

3. Miscellaneous Property in Sec.

S T R

S T R

REGISTER'S OFFICE) ..SS

IRON COUNTY, MICH.)

RECEIVED FOR RECORD THE 21ST DAY OF

FEBRUARY A.D. 19 95 AT

2:45 O'CLOCK P.M. AND RECORDED IN LIBER

6 OF L.C. RECORDS

ON PAGE 384

DEPUTY REGISTER OF DEEDS

Register of Deeds Stamp & File Number

4. Lot No. , Recorded Plat

5. Private Claims

Quarter Corner 36, 1, T44N R37W T43N

I, Gary L. Pisoni in a field survey on November 7, 19 94

do hereby certify that under requirements of P.A. 74, Michigan P.A. of 1970, the corner points mentioned in lines 1 and 2 above were in conformance with regulations and rules therefore as required in the current manual of survey instructions of the United States Department of the Interior, Bureau of Land Management or by a decree of a Court of Law and/or that the corner points mentioned in lines 3, 4 and 5 above were in conformance with the rules of the Michigan Board of Land Surveyors or by a Decree of a Court of Law; established, re-established, monumented, re-monumented, recovered, found as expressed below:

NOTE: Not more than 4 corners, all in the same town and range, may be recorded on this certificate.

	A	B	C	D	E	F	G	H	I	J	K	L	M
2	6		5		4		3		2		1		
3													
4	7		8		9		10		11		12		
5													
6	18		17		16		15		14		13		
7													
8	19		20		21		22		23		24		
9													
10	30		29		28		27		26		25		
11													
12	31		32		33		34		35		36		
13													

A. Description of original monument and accessories and/or subsequent restoration:

Original corner established by Austin Burt, U.S. Deputy Surveyor on July 5, 1847.

Original corner: Sugar Post

Original bearing trees:

Sugar	14"	N 82° E	14 links (9.24 feet)
Spruce	7"	N 40° W	22 links (14.52 feet)

B. Description of corner evidence found and/or method applied in restoring or reestablishing corner:

No evidence of original corner or bearing tree remains. Corner located on the South side of U.S. 2. Corner set by a single proportionate measurement and on line between Southwest and Southeast section corners of Section 36. Set an aluminum pipe monument 3" above ground surface.


County Record Research on file with County Representative office.

PEER GROUP APPROVED Gary L. Pisoni COUNTY REPRESENTATIVE A.P. 11-30-94

C. Description of monument for corner and accessories established to perpetuate locating the position of the corner:

At the corner position, I set a 2" diameter by 30" long split base aluminum pipe monument with a 3" cast aluminum cap, stamped to read: Iron County Remonumentation, T44N, R37W, 1/4, S-36, S-1, T43N, 1994, RLS- 27457 from which I established the following new blazed and scribed bearing trees:(all measurements taken to a nail in side of tree)

Red Maple	6"	S 30° E	50.02 feet
Yellow Birch	12"	S 28° W	10.67 feet
Sugar Maple	6"	S 54° W	23.89 feet
Steel sign post		South	0.93 feet

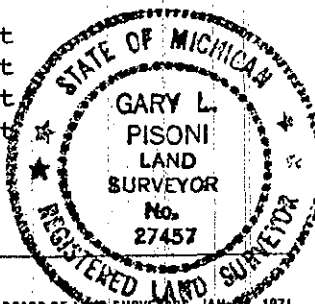

Signed by Gary L. Pisoni

Date 1-9-95

Surveyor's Michigan License No. 27457

FORM APPROVED BY MICHIGAN STATE BOARD OF LAND SURVEYORS, JAN. 28, 1971 REVISED MAY 14, 1975 REVISED JAN., 1983