

LAND CORNER RECORDATION CERTIFICATE
Filing Requirement of Act 74, Mich. P.A. 1970

For corners in
Iron

(County)	Located in:	Corner Code #
1. Public Land Survey	T 45N R 31W	A5
	T 45N R 31W	B7
	T R	
2. Property Controlling In Section	S 18 T 45N R 31W	15
	S T R	
3. Miscellaneous Property in Sec.	S T R	
	S T R	

Register of Deeds Stamp & File Number

4. Lot No. _____, Recorded Plat _____
5. Private Claims _____

	A	B	C	D	E	F	G	H	I	J	K	L	M
2	6	5	4	3	2	1							
3													
4	7	8	9	10	11	12							
5													
6	18	17	16	15	14	13							
7													
8	19	20	21	22	23	24							
9													
10	30	29	28	27	26	25							
11													
12	31	32	33	34	35	36							
13													

I, Stephan J. Szyszkoski, in a field survey on June 09, 1993, 19____, do hereby certify that under requirements of P.A. 74, Michigan P.A. of 1970, the corner points mentioned in lines 1 and 2 above were in conformance with regulations and rules therefore as required in the current manual of survey instructions of the United States Department of the Interior, Bureau of Land Management or by a decree of a Court of Law and/or that the corner points mentioned in lines 3, 4 and 5 above were in conformance with the rules of the Michigan Board of Land Surveyors or by a Decree of a Court of Law: established, re-established, monumented, re-monumented, recovered, found as expressed below:

NOTE: Not more than 4 corners, all in the same town and range, may be recorded on this certificate.

A. Description of original monument and accessories and/or subsequent restoration:


- (A5) Section corner common to Sections 7-18, T45N-R31W and 12-13, T45N-R32W. Corner previously recorded in 1971 by Arthur O. Enger, M.S., as a 1"x36" iron pipe with 4" aluminum cap set by proportionate measurement with the following NBTs: 10" Sugar S51E 11.1', 7" Sugar S24W 23.9', 9" Sugar N40W 13.7'. Found no subsequent record.
- (B7) Quarter corner common to Sections 18-19. Original corner established in 1849 by U.S. Deputy Surveyor John Burt. Original BTs: Y. Birch 12 S34W 22, Sugar 10 N31E 39. Found no subsequent record.
- (15-Sec. 18) West 1/16 corner between Sections 18-19. Corner not established in original survey. Found no subsequent record.

B. Description of corner evidence found and/or method applied in restoring or reestablishing corner:

- (A5) Found and accepted monument as described above at record bearing and distance from 2 of the 1971 NBTs: 13" Sugar N40W 13.7', and 14" Sugar S51E 11.1', both in good condition with blazes partially overgrown. Marked two new bearing trees as described below.
- (B7) Original post not recovered. Re-monumented the corner at record bearing and distance from the probable remains of the two original bearing trees. The Y. Birch is now a 25" dia. dead snag. Felled the tree at BH to reveal hollow interior and found evidence of old blazes at BH and base but no notch or scribing visible. The Sugar now consists of ground level stump remains with distinct root holes. The corner falls at the proportionate departure, 3.67' north of a straight line between adjacent section corners. At the position for the corner, I placed a 1"x36" iron pipe capped with a 4" dia. cast aluminum MDNR tablet, appropriately stamped.
- (15-Sec. 18) Found no evidence of prior monumentation. Established the corner on a straight line between section corner 1304.90' west and 1/4 corner 1318.09' east, being the proportionate position. At the position for the corner, I placed a 1"x36" iron pipe capped with a 4" dia. cast aluminum MDNR tablet, appropriately stamped. Corner falls in a leatherleaf bog.

C. Description of monument for corner and accessories established to perpetuate locating the position of the corner:

- | | | |
|--|---|---|
| (A5) Found 1" pipe with 4" alum. cap. Blazed and scribed the following new bearing trees (bearings magnetic):
16" Maple N48E 34.7' "S7 NBT"
12" Sugar S57W 11.0' "S13 NBT" | (B7) Set a 1" pipe with 4" alum. cap. Blazed and scribed the following new bearing trees (bearings magnetic):
16" Sugar S44W 9.4' "1/4S NBT"
15" Sugar N12E 12.1' "1/4S NBT"
6" Sugar East 13.5' "1/4S NBT"
18" Sugar N58W 38.7' "1/4S NBT"
Placed a 3" sugar post adjacent to corner. | (15-Sec. 18) Set 1" pipe with 4" cap. Blazed and scribed the following bearing trees (bearings magnetic):
3" Tamarack S54E 15.1' "1/16S BT"
13" White Pine S09E 32.3' "1/16S BT"
5" Spruce S61W 11.8' "1/16S BT"
7" Tamarack N18E 20.1' "1/16S BT"
placed a 3" squared spruce post adjacent to the corner. |
|--|---|---|

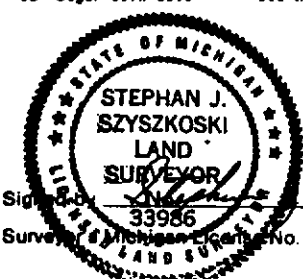

Signature: Stephan J. Szyszkoski Date: 6-28-93
Surveyor's Michigan License No. 33986