

**LAND CORNER RECORDATION CERTIFICATE**  
**Filing Requirement of Act 74, Mich. P.A. 1970**

For corners in  
Iron  
 (County)

1. Public Land Survey	Located In:	Corner Code #
	T <u>45N</u> R <u>31W</u>	<u>C9</u>
	T _____ R _____	_____
	T _____ R _____	_____
	T _____ R _____	_____
2. Property Controlling In Section	S <u>19</u> T <u>45N</u> R <u>31W</u>	<u>7</u>
	S <u>18</u> T <u>45N</u> R <u>31W</u>	<u>14</u>
3. Miscellaneous Property in Sec.	S _____ T _____ R _____	_____
	S _____ T _____ R _____	_____

Register of Deeds Stamp & File Number

4. Lot No. \_\_\_\_\_, Recorded Plat \_\_\_\_\_  
 5. Private Claims \_\_\_\_\_

I, Stephan J. Szyszkoski, in a field survey on June 29, 1993, 19\_\_\_\_\_, do hereby certify that under requirements of P.A. 74, Michigan P.A. of 1970, the corner points mentioned in lines 1 and 2 above were in conformance with regulations and rules therefore as required in the current manual of survey instructions of the United States Department of the Interior, Bureau of Land Management or by a decree of a Court of Law and/or that the corner points mentioned in lines 3, 4 and 5 above were in conformance with the rules of the Michigan Board of Land Surveyors or by a Decree of a Court of Law; established, re-established, monumented, re-monumented, recovered, found as expressed below:

**NOTE:** Not more than 4 corners, all in the same town and range, may be recorded on this certificate.

	A	B	C	D	E	F	G	H	I	J	K	L	M
2													
3													
**A. Description of original monument and accessories and/or subsequent restoration:**


(C9) Corner common to Sections 19-20-29-30. Corner previously recorded in 1982 by Kieth Sackett, RLS as follows: Set 1" I.D.x32" IP with 4" aluminum cap at post set from original bearing tree. 1982 NBTs: 6" Spruce S52N 18.0', 5" Spruce S77E 9.8', 5" Balsam N54E 6.9'. Found no subsequent record.  
 (7-Sec. 19) North 1/16 corner between Sections 19-20. Corner not established in the original survey. Found no subsequent record.  
 (14-Sec. 18) South 1/16 corner between Sections 18-17. Corner not established in the original survey. Found no subsequent record.

**B. Description of corner evidence found and/or method applied in restoring or reestablishing corner:**

(C9) Found and accepted corner monument as previously recorded at record bearing and distance from the 2 spruce NBTs, both in good condition. The Balsam NBT had come down. Marked 2 new witnesses trees as described below.  
 (7-Sec. 19) Established the corner midway and on a straight line between Section and Quarter corners 1320.23' north and south. Found an 8" dead maple S29E 21.9' with a location poster dated 1980 for a forester's approximate corner. At the position for the corner, placed a 1"x36" iron pipe capped with a 4" dia. cast aluminum MDRR tablet, appropriately stamped. The center of a road, which bears N58E, is north 29 ft. from the corner. The corner falls about 45' east of the east edge of a R. Pine plantation.  
 (14-Sec. 18) Found no evidence of prior monumentation. Established the corner on a straight line between quarter and section corners 1320.23' north and south. At the position for the corner, placed a 1"x32" iron pipe capped with a 4" dia. cast aluminum MDRR tablet, appropriately stamped.

**C. Description of monument for corner and accessories established to perpetuate locating the position of the corner:**

(C9) Found 1" pipe with 4" alum cap. Blazed and scribed the following new bearing trees (bearings magnetic): 4" Spruce N55W 22.1' "819 NBT" 8" Elm N12E 21.4' "820 NBT"	(7-Sec. 19) Set 1" pipe with 4" cap. Blazed and scribed the following bearing trees (bearings magnetic): 3" Balsam N68E 27.8' "1/16S BT" 4" R. Pine S51W 61.0' "1/16S BT" 6" Aspen N19W 38.6' "1/16S BT" Placed a 3" squared R. Pine post 0.6' East of the corner.	(14-Sec. 18) Set 1" pipe with 4" cap. Blazed and scribed the following bearing trees (bearings magnetic): 5" Sugar N15E 18.3' "1/16S BT" 8" Sugar N19W 24.9' "1/16S BT" 5" Maple S47W 10.7' "1/16S BT" 4" Maple S17E 17.0' "1/16S BT"
--	---	--

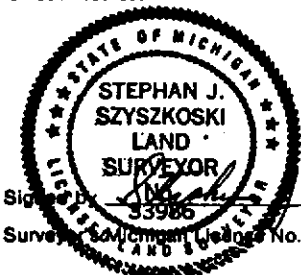

Signature: Stephan J. Szyszkoski Date: 6-28-93  
 Surveyor's License No. 33986