

LAND CORNER RECORDATION CERTIFICATE
Filing Requirement of Act 74, Mich. P.A. 1970 as Amended

For corners in

Iron	Located In:	Corner Code #
(County)		
1. Public Land Survey	T <u>45NR</u> <u>31W</u>	<u>18</u>
	T _____ R _____	_____
	T _____ R _____	_____
2. Property Controlling in Section	S _____ T _____ R _____	_____
	S _____ T _____ R _____	_____
3. Miscellaneous Property in Sec.	S _____ T _____ R _____	_____
	S _____ T _____ R _____	_____

Register of Deeds Stamp & File Number

4. Lot No. _____, Recorded Plat _____
 5. Private Claims _____

Apr 13 2006

I, Stephan J. Szyszkoski, in a field survey on _____, 20____ do hereby state that under requirements of P.A. 74, Michigan P.A. of 1970, the corner points mentioned in lines 1 and 2 above were in conformance with regulations and rules therefore as required in the current manual of survey instructions of the United States Department of the Interior, Bureau of Land Management or by a decree of a Court of Law and /or that the corner points mentioned in lines 3, 4 and 5 above were in conformance with the rules of the Michigan Board of Land Surveyors or by a Decree of a Court of Law; established, re-established, monumented, recovered, found as expressed below:

NOTE: Not more than 2 corners, all in the same town and range, may be recorded on this certificate.

	A	B	C	D	E	F	G	H	I	J	K	L	M
1													
2	6	5	4	3	2	1							
3													
4	7	8	9	10	11	12							
5													
6	18	17	16	15	14	13							
7													
8	19	20	21	22	23	24							
9													
10	30	29	28	27	26	25							
11													
12	31	32	33	34	35	36							
13													

A. Description of original monument and accessories and/or subsequent restoration:


(18) Quarter corner common to Sections 22 and 23. 1849 - Established by John Burt, Deputy Surveyor: North between Sections 22 & 23 ...40.00 Sugar tree 12 in. diam. quarter section corner. ...80.00 Set sugar post corner of Sections 14,15,22,23. 1990 - Corner reestablished by single proportionate measurement between Section corners by Charles F. Clark RLS. Set 5/8"x24" capped rebar 1 foot north of boulder, witnessed by double-headed nails in: 3" Balsam N05W 45.40', 3" Balsam N72E 5.42', 3" Balsam S30W 35.33', 7" Spruce S75W 65.24'.

B. Description of corner evidence found and/or method applied in restoring or reestablishing corner:

(18) The original corner tree was not recovered. Found an old 1"x1" square iron pin, set by an unknown surveyor, not of record, identical to those previously recovered and accepted by the undersigned and others at the SW corner of Sec. 23, the SE corner of Sec. 23 and the West 1/16 corner between Sections 23 and 26. The pin is located 10.3' west and 4.6' north of the position proportionate to the original record and I accept the pin as the best available evidence of the position of the original corner. Found the 1990 monument of record, in good condition, at the record position, which I did not accept as marking the position of the corner.

C. Description of monument for corner and accessories established to perpetuate locating the position of the corner:

(18) Found 1" square iron pin. Set measuring nails in:
 6" W.Spruce N60E 24.9' mrkd "1/4S NBT"
 5" W.Spruce S67E 21.6' do
 4" W.Spruce S60W 31.7' do
 6" W.Spruce N37W 29.2' do
 Fd 5/8" capped rebar, the 1990 monument of record, S62E 11.45'
 Set sq'd Cedar post adjacent. Bearings are magnetic. Distances are to nail with tag.

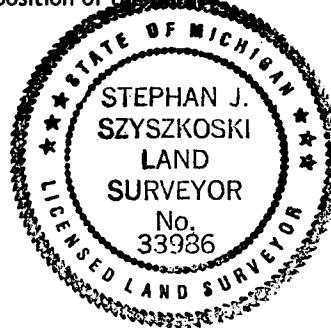

Signed by Stephan J. Szyszkoski
 Surveyor's Michigan License No. 33986

Date 8/11/06