

LAND CORNER RECORDATION CERTIFICATE
Filing Requirement of Act 74, Mich. P.A. 1970 as Amended

For corners in

Iron	Located In:	Corner Code #
<small>(County)</small>		
1. Public Land Survey	T _____ R _____	_____
	T _____ R _____	_____
	T _____ R _____	_____
2. Property Controlling in Section	S _____ T _____ R _____	_____
	S 18 T 45N R 31W	14
	S 18 T 45N R 31W	16
3. Miscellaneous Property in Sec.	S _____ T _____ R _____	_____
	S _____ T _____ R _____	_____

Register of Deeds Stamp & File Number

4. Lot No. _____, Recorded Plat _____
 5. Private Claims _____

Oct 11 2005

I, Stephan J. Szyszkoski, in a field survey on _____, 20____ do hereby state that under requirements of P.A. 74, Michigan P.A. of 1970, the corner points mentioned in lines 1 and 2 above were in conformance with regulations and rules therefore as required in the current manual of survey instructions of the United States Department of the Interior, Bureau of Land Management or by a decree of a Court of Law and /or that the corner points mentioned in lines 3, 4 and 5 above were in conformance with the rules of the Michigan Board of Land Surveyors or by a Decree of a Court of Law; established, re-established, monumented, recovered, found as expressed below:

NOTE: Not more than 2 corners, all in the same town and range, may be recorded on this certificate.

A. Description of original monument and accessories and/or subsequent restoration:

(14-Sec. 18) South 1/16 corner between Sections 17 and 18. Established by the undersigned in 1993, midway and on a straight line between Section corner to south and Quarter corner to north. Set 1"IDx36" I.pipe with 4" alum. MDNR cap. 5" Sugar N15E 18.3', 8" Sugar N19W 24.9', 5" Maple S47W 10.7', 4" Maple S17E 17.0'.

(16-Sec. 18) East 1/16 corner between Section 18 and 19. Established by the undersigned in 1993 midway and on a straight line between Section corner to East and Quarter corner to West. Set 1"IDx36" I.pipe with 4" alum. MDNR cap. 3" Spruce S47W 22.9', 4" Balsam S08W 47.1', 3" Balsam S31E 21.1'.

B. Description of corner evidence found and/or method applied in restoring or reestablishing corner:

(14-Sec. 18) Recovered the 1993 monument in good condition and at record bearing and distance from the 1993 accessories, the Sugar NW and the Maple SE now dead and down. Left the monument in place and marked two new accessories as described below.

(16-Sec. 18) Recovered the 1993 monument in good condition and at record bearing and distance from the 3 bearing trees, all in good condition with scribing visible. Marked one new bearing tree.

C. Description of monument for corner and accessories established to perpetuate locating the position of the corner:

(14) Found 1"ID I.pipe with 4" alum.

MDNR cap. Set measuring nails in:

6" Sugar N14E 18.6' *

7" Maple S47W 10.9' *

10" Sugar S55E 27.3' mrkd "1/16S BT"

9" Sugar N61W 45.7' do

Set sq'd spruce post adjacent. Bearings

are magnetic. Distances are to nail

with tag. * denotes 1993 BT.

(16) Found 1"ID I.pipe with 4" alum.

MDNR cap. Set measuring nails in:

5" Balsam S30E 21.5' *

7" Balsam S08W 47.3' *


6" Spruce S47W 23.1' *

4" Spruce N65W 40.8' mrkd "1/16S BT"

Set sq'd cedar post adjacent. Bearings

are magnetic. Distances are to nail

with tag.

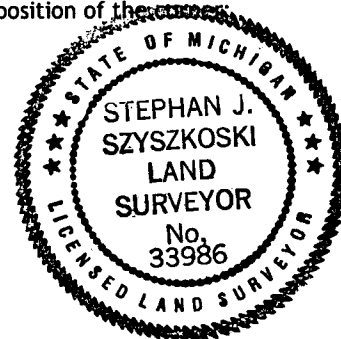

Signed by Stephan J. Szyszkoski

Date 10/12/05

Surveyor's Michigan License No. 33986

For the Michigan Department of Natural Resources, Office of Land and Facilities

FORM APPROVED BY MICHIGAN STATE BOARD OF PROFESSIONAL SURVEYORS, JAN. 28, 1971

Revised May 14, 1975

Revised Jan., 1983

Revised Oct., 1995