

LAND CORNER RECORDATION CERTIFICATE
 Filing Requirement of Act 74, Mich. P.A. 1970 as Amended

For corners in

<u>Iron</u> (County)	Located In:	Corner Code #
1. Public Land Survey	T 45N R 31W	F3
	T 45N R 31W	G2
2. Property Controlling in Section	T _____ R _____	_____
	S _____ T _____ R _____	_____
	S _____ T _____ R _____	_____
3. Miscellaneous Property in Sec.	S _____ T _____ R _____	_____
	S _____ T _____ R _____	_____
4. Lot No. _____, Recorded Plat _____		
5. Private Claims _____		

Register of Deeds Stamp & File Number

	A	B	C	D	E	F	G	H	I	J	K	L	M
1													
2	6		5			4	●	3		2		1	
3						●							
4	7		8			9		10		11		12	
5													
6	18		17			16		15		14		13	
7													
8	19		20			21		22		23		24	
9													
10	30		29			28		27		26		25	
11													
12	31		32			33		34		35		36	
13													

I, Stephan J. Szyszkoski, in a field survey on G2 05/17/2010 do hereby state that under requirements of P.A. 74, Michigan P.A. of 1970, the corner points mentioned in lines 1 and 2 above were in conformance with regulations and rules therefore as required in the current manual of survey instructions of the United States Department of the Interior, Bureau of Land Management or by a decree of a Court of Law and /or that the corner points mentioned in lines 3, 4 and 5 above were in conformance with the rules of the Michigan Board of Land Surveyors or by a Decree of a Court of Law; established, re-established, monumented, recovered, found as expressed below:

NOTE: Not more than 2 corners, all in the same town and range, may be recorded on this certificate.

A. Description of original monument and accessories and/or subsequent restoration:

(F3) Quarter corner common to Sections 4 and 9. 1970 - Corner remonumented by A.O.Enger RLS midway and on line between section corners 39.835 chains to east and west. Set 1"IDx36" I.pipe with 4" aluminum cap. W.Pine 14" S54W 14.1', W.Pine 13" S46 1/2E 14.3'.

(G2) Quarter corner common to Sections 3-4. 1970 - Reestablished by A.O.Enger RLS by proportionate measurement on line between section corner 39.975 ch. south and section corner 40.485 ch. north. Set 1"IDx36" I.pipe with 4" aluminum cap. W.Spruce 10" S04E 13.3', W.Spruce 10" N74E 12.1'.

B. Description of corner evidence found and/or method applied in restoring or reestablishing corner:

(F3) Found the 1970 monument in good condition and at record bearing and distance from the 1970 witnesses, now both standing dead stubs with scribing visible. Checked the position of the monument with respect to Section corners found 2631.17' west and 2623.76' east and found it to be substantially in accord with the record. Accepted the monument as a careful and faithful reestablishment of the position of the original corner.

(G2) Found the 1970 monument in good condition and at record bearing and distance from the 1970 witnesses. The W.Spruce NBT SE is in good condition with overgrown blazes. The W.Spruce NBT NE is a rotting stump. Accepted the monument as a careful and faithful reestablishment of the position of the original corner.


C. Description of monument for corner and accessories established to perpetuate locating the position of the corner:

(F3) Found 1"ID I.pipe with 4" alum. MDNR cap. Set measuring nail with MDNR tag in the side of:
 4" W.Spruce N43E 28.7' mrkd "1/4S NBT"
 6" W.Spruce S67E 11.8' do
 8" W.Spruce S19E 35.3' do
 3" Maple N46W 12.3' do
 Sq'd cedar post adjacent. Bearings magnetic.

(G2) Found 1"ID I.pipe with 4" alum. MDNR cap. Set measuring nail with MDNR tag in the side of:
 12" Spruce S01W 13.8' 1970 NBT
 3" Poplar S62E 17.6' mrkd "1/4S NBT"
 10" Maple N73W 2.3' do
 6" Spruce N30W 29.4' do
 Sq'd cedar post adjacent. Bearings magnetic.

Signed by Stephan J. Szyszkoski
 Surveyor's Michigan License No. 33986

Date 08/26/2010

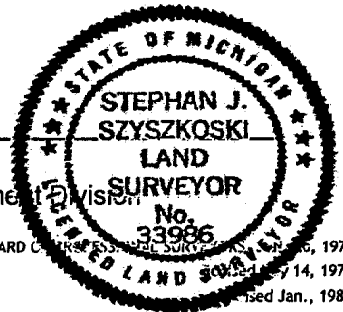

For the Michigan Department of Natural Resources and Environment, Forest Management Division