

LAND CORNER RECORDATION CERTIFICATE

IRON COUNTY FILING REQUIREMENT OF ACT 74, MICH. P.A.1970

FOR CORNERS OF--:	LOCATED IN--:	CORNER CODE NUMBER
1. PUBLIC LAND SURVEY	T. 45N ^{N.} X. R. 32 ^{E.} W.	Meander corner between C11 & C12
2. PROPERTY CONTROLLING IN SECTION	32, T. 45 ^{N.} X. R. 32 ^{E.} W.	1
3. MISCELLANEOUS PROPERTY IN SECTION	T. _____ ^{N.} X. R. _____ ^{E.} W.	
4. LOT NO. _____, RECORDED PLAT _____		
5. PRIVATE CLAIMS _____		

REGISTER OF DEEDS STAMP AND FILING NUMBER

I, Keith L. Sackett, do hereby certify that under requirements of P.A. 74, Michigan P.A. of 1970, the corner points mentioned in lines 1 and 2 above were, in a field survey on 5-5-83, 19____, established, re-established, monumented, re-monumented, recovered or restored as expressed below and in conformance with regulations and rules therefore as required in the current manual of survey instructions of the United States Department of the Interior, Bureau of Land Management or by a decree of a court of law. Furthermore, that the corner points mentioned in lines 3, 4 and 5 above were, in a field survey on _____, 19____, found, recovered, restored, established or re-established as expressed below and in conformance with the rules of the Michigan State Board of Registration for Land Surveyors or, by a Decree of a Court of law:

A. Description of original monument and accessories and/or subsequent restoration:
Meander corner: Original monument and accessories not found.

Corner 1: Not set on original survey nor subsequently apparently. Found old axle shaft by foot bridge 132.69 ft southwest.

B. Description of corner evidence found and/or method applied in restoring or re-establishing corner:

Meander corner: Restored on line between corners north and south on north side of lake in Sections 31 & 32.

Corner 1: Established midway and on line between corners east and west.

C. Description of monument for corner and accessories established to perpetuate locating the position of the corner:

Meander corner: Set 1" I.D. by 32" I.P.,
w/4" alum. cap.
6" Cedar N13E 22.6 ft. MC, BT
7" Spruce N32W 17.5 ft MC, BT
9" Spruce S59W 29.0 ft. MC, BT

Corner 1: Set 1" I.D. by 32" I.P.
w/4" alum. cap.
One chain east to stream old axle shaft by foot bridge 132.69 southwest.

SIGNED BY _____ DATE _____

SURVEYOR'S MICHIGAN REGISTRATION NO. _____


(SEAL)

FOR STATE AND UNITED STATES AGENCIES:

SIGNED BY _____ DATE _____

APPROVED AND SIGNED BY Keith L. Sackett
CHIEF OF SURVEY DISTRICT
MICHIGAN REGISTERED LAND SURVEYOR

DATE 6-29-83

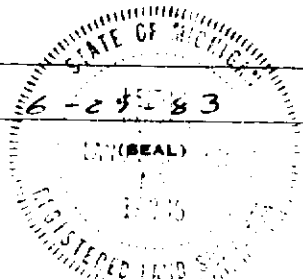

SURVEYOR'S MICHIGAN REGISTRATION NO. 19006