

LAND CORNER RECORDATION CERTIFICATE
Filing Requirement of Act 74, Mich. P.A. 1970

For corners in

Iron _____	Located In:	Corner Code #	
(County)			
1. Public Land Survey	T _____ R _____	_____	
	T _____ R _____	_____	
	T _____ R _____	_____	
	T _____ R _____	_____	
2. Property Controlling in Section	S <u>36</u> T <u>45N</u> R <u>32W</u>	<u>1</u>	
	S <u>36</u> T <u>45N</u> R <u>32W</u>	<u>5</u>	
3. Miscellaneous Property in Sec.	S _____ T _____ R _____	_____	
	S _____ T _____ R _____	_____	

Register of Deeds Stamp & File Number

4. Lot No. _____, Recorded Plat _____
 5. Private Claims _____

Apr 01 2003

I, Stephan J. Szyszkoski, in a field survey on _____, 20____ do hereby state that under requirements of P.A. 74, Michigan P.A. of 1970, the corner points mentioned in lines 1 and 2 above were in conformance with regulations and rules therefore as required in the current manual of survey instructions of the United States Department of the Interior, Bureau of Land Management or by a decree of a Court of Law and /or that the corner points mentioned in lines 3, 4 and 5 above were in conformance with the rules of the Michigan Board of Land Surveyors or by a Decree of a Court of Law; established, re-established, monumented, recovered, found as expressed below:

NOTE: Not more than 2 corners, all in the same town and range, may be recorded on this certificate.

1	A	B	C	D	E	F	G	H	I	J	K	L	M
2		6		5		4		3		2		1	
3													
4		7		8		9		10		11		12	
5													
6		18		17		16		15		14		13	
7													
8		19		20		21		22		23		24	
9													
10		30		29		28		27		26		25	
11													
12		31		32		33		34		35		36	
13													

A. Description of original monument and accessories and/or subsequent restoration:


- (1-Sec. 36) West 1/16 corner between Sections 25 & 36. Not established in the original survey. Found no subsequent record.
- (5-Sec. 36) North 1/16 corner, Section 36. Not established in the original survey. Found no subsequent record.

B. Description of corner evidence found and/or method applied in restoring or reestablishing corner:

- (1-Sec. 36) Established the corner midway and on a line of mean true bearing between Section and Quarter corners 1315.67' west and east.
- (5-Sec. 36) Established the corner midway and on a straight line between Quarter corner and Center of Section 1311.98' north and south. From the corner monumented, I found a 1 3/8" ID iron pipe, projecting 12", placed by persons unknown, S81W 25.0' distant.

C. Description of monument for corner and accessories established to perpetuate locating the position of the corner:

- | | |
|--|---|
| (1) Set 1"IDx32" I.pipe with 4" alum. MDNR cap. Blazed, scribed, and set measuring nails in:
5" Balsam N03E 50.05' "1/16S BT"
4" Cherry N50E 20.75' do
4" Poplar S53W 6.60' do
4" Poplar N26W 18.55' do
Set squared spruce post adjacent.
Bearings are magnetic. Distances are to nail with tag. | (5) Set 1"IDx32" I.pipe with 4" alum. MDNR cap. Blazed, scribed, and set measuring nails in:
5" dbl Y.Birch N49W 37.45' "1/16S BT"
7" Maple S79E 14.65' do
11" Spruce S03E 11.40' do
8" Y.Birch S85W 22.90' do
Set sq'd spruce post adjacent. Bearings are magnetic. Distances are to nail with tag. |
|--|---|

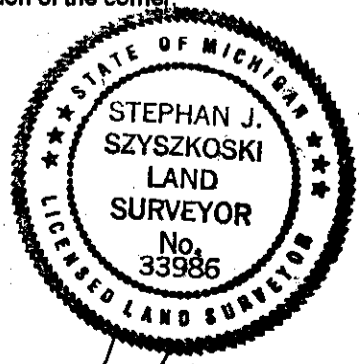

Signed by Stephan J. Szyszkoski
 Surveyor's Michigan License No. 33986

Date 5/29/03