

**LAND CORNER RECORDATION CERTIFICATE**  
**Filing Requirement of Act 74, Mich. P.A. 1970**

For corners in

Iron

(County)

Located in:

Corner Code #

1. Public Land Survey

T 45N R 32W

E13

T R

T R

T R

T R

T R

T R

2. Property Controlling  
 in Section  
 3. Miscellaneous  
 Property in Sec.

S 32 T 45N R 32W

S T R

S T R

S T R

S T R

4

4. Lot No. \_\_\_\_\_, Recorded Plat \_\_\_\_\_

Sep 25 2003

I, Stephan J. Szyszkoski, in a field survey on \_\_\_\_\_ 20\_\_\_\_ do hereby state that under requirements of P.A. 74, Michigan P.A. of 1970, the corner points mentioned in lines 1 and 2 above were in conformance with regulations and rules therefore as required in the current manual of survey instructions of the United States Department of the Interior, Bureau of Land Management or by a decree of a Court of Law and/or that the corner points mentioned in lines 3, 4 and 5 above were in conformance with the rules of the Michigan Board of Land Surveyors or by a Decree of a Court of Law, established, re-established, monumented, recovered, found as expressed below:

NOTE: Not more than 2 corners, all in the same town and range, may be recorded on this certificate.

A	B	C	D	E	F	G	H	I	J	K	L	M
1	6	5	4	3	2	1						
2												
3												
4	7	8	9	10	11	12						
5												
6	18	17	16	15	14	13						
7												
8	19	20	21	22	23	24						
9												
10	30	29	28	27	26	25						
11												
12	31	32	33	34	35	36						
13												


(A) Description of original monument and accessories and/or subsequent reestablishment by Dean C. Delamater from two 610 bearing trees and the remains of what possibly was the original post. Set 1" pipe with 4" brass cap. 10" H. Maple N72W 34 links, 10" H. Maple N52E 56 links.  
 (4-Sec. 32) Northwest 1/16 corner, Section 32. Not established in the original survey.

B. Description of corner evidence found and/or method applied in restoring or reestablishing corner:

(E13) Recovered the monument in good condition and at record bearing and distance from the 1951 witness trees. The H. Maple NW is in good condition with overgrown blazes. The other NBT is now a rotting stump. The monument cap was found stamped incompletely: "32-33-4-5 32W". Left the monument in place and made new witnesses as described below.  
 (4-Sec. 32) Found no evidence of prior monumentation on the ground. Established the corner at the intersection of straight lines connecting opposite 1/16 corners.

C. Description of monument for corner and accessories established to perpetuate locating the position of the corner.

(E13) Found 1" ID I. pipe with 4" brass NI (4) Set 1" ID x 32" I. pipe with 4" alum. Dept. of Conservation cap. Blazed, MNR cap. Blazed, scribed, and set scribed, and set meas. nails in: measuring nails in:  
 20" Sugar K66M 22.6' \* S33 NBT 9" W. Spruce S62E 12.6' \* 1/16S 8T"  
 8" Sugar N26E 13.2' \* S4 NBT 9" W. Spruce S61W 19.2' do  
 11" Y. Birch S37E 33.1' \* S4 NBT 4" Balsam N53W 0.65' do  
 10" Sugar S20E 13.0' \* S4 NBT 9" W. Spruce N14E 23.7' do  
 Bearings are magnetic. Distances are to Set squared spruce post adjacent.  
 Bearings are magnetic. Distances are to nail with tag. \* denotes 1951 NBT.

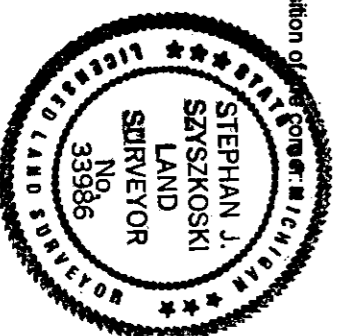

Signed by Stephan J. Szyszkoski  
 Surveyor's Michigan License No. 33986

Date 9/30/03