

**LAND CORNER RECORDATION CERTIFICATE**  
**Filing Requirement of Act 74, Mich. P.A. 1970**


For corners in \_\_\_\_\_

Iron \_\_\_\_\_  
 (County)

Located in: \_\_\_\_\_

Corner Code # \_\_\_\_\_

|                         |             |              |              |
|-------------------------|-------------|--------------|--------------|
| 1. Public Land Survey   | T _____     | R _____      | _____        |
|                         | T _____     | R _____      | _____        |
|                         | T _____     | R _____      | _____        |
| 2. Property Controlling | S <u>31</u> | T <u>45N</u> | R <u>32W</u> |
| in Section              | S _____     | T _____      | R _____      |
| 3. Miscellaneous        | S _____     | T _____      | R _____      |
| Property in Sec.        | S _____     | T _____      | R _____      |

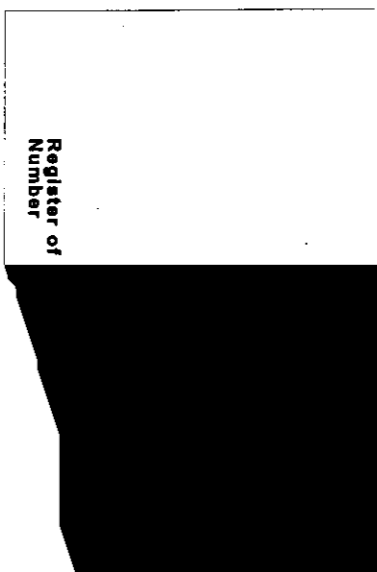


4. Lot No. \_\_\_\_\_, Recorded Plat \_\_\_\_\_  
 5. Private Claims \_\_\_\_\_

Aug 14 2002

I, Stephan J. Szyzkoski, in a field survey on \_\_\_\_\_, 19\_\_\_\_ do hereby state that under requirements of P.A. 74, Michigan P.A. of 1970, the corner points mentioned in lines 1 and 2 above were in conformance with regulations and rules therefore as required in the current manual of survey instructions of the United States Department of the Interior, Bureau of Land Management or by a decree of a Court of Law and /or that the corner points mentioned in lines 3, 4 and 5 above were in conformance with the rules of the Michigan Board of Land Surveyors or by a Decree of a Court of Law; established, re-established, monumented, recovered, found as expressed below:

**NOTE: Not more than 2 corners, all in the same town and range, may be recorded on this certificate.**

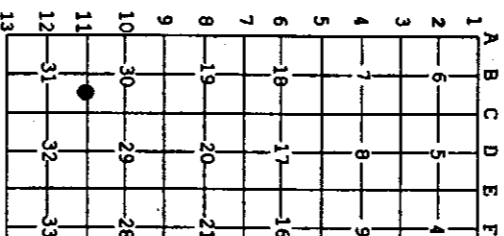

A. Description of original monument and accessories and/or subsequent restoration: "Established midway and on (2-Sec. 31) East 1/16 corner between Sections 30-31. 1983. Record of K.L.Sackett RLS: "Established midway and on corners east and west. Set 1 "1DX32" I.P. w/4" alum. cap. 8" Spruce N70E 32.0', 10" Spruce S29E 40.7', 6" Spruce

B. Description of corner evidence found and/or method applied in restoring or reestablishing corner:

(2-Sec. 31) Recovered the 1983 monument in good condition and at record bearing and distance from the record access measurement to this monument shows that it is located 7.46' southerly of the position of record. Removed the 1983 a new monument midway and on a line of mean true bearing between monumented Section and Quarter corners 1314.88'

C. Description of monument for corner and accessories established to perpetuate locating the position of the corner

- (2) Set 1 "1DX32" I. pipe with 4" alum. MDMR cap. Blazed and scribed:
- 7" W. Spruce S65E 56.0' "1/16S BT"
- 4" W. Spruce S61W 46.0' do
- The 1983 wits, remeasured:
- 10" Spruce N89E 30.7' fd. w/ markings do
- 14" Spruce S22E 47.6' do
- Set squared cedar post adjacent.
- Bearings are magnetic. Distances are to notch in lower blaze.



Signed by Stephan J. Szyzkoski  
 Surveyor's Michigan License No. 33986

Date 8/25