

**LAND CORNER RECORDATION CERTIFICATE**  
**Filing Requirement of Act 74, Mich. P.A. 1970**

For corners in

Iron

Located In:

Corner Code #

(County)

- |                                    |      |       |     |
|------------------------------------|------|-------|-----|
| 1. Public Land Survey              | T 45 | R 32N | K10 |
|                                    | T    | R     |     |
|                                    | T    | R     |     |
|                                    | T    | R     |     |
| 2. Property Controlling in Section | S    | T     | R   |
|                                    | S    | T     | R   |
| 3. Miscellaneous Property in Sec.  | S    | T     | R   |

4. Lot No. \_\_\_\_\_, Recorded Plat \_\_\_\_\_  
 5. Private Claims \_\_\_\_\_

May 12 2003

I, Stephan J. Szyszkoski, in a field survey on 20 do hereby state that under requirements of P.A. 74, Michigan P.A. of 1970, the corner points mentioned in lines 1 and 2 above were in conformance with regulations and rules therefore as required in the current manual of survey instructions of the United States Department of the Interior, Bureau of Land Management or by a decree of a Court of Law and/or that the corner points mentioned in lines 3, 4 and 5 above were in conformance with the rules of the Michigan Board of Land Surveyors or by a Decree of a Court of Law, established, re-established, monumented, recovered, found as expressed below:

NOTE: Not more than 2 corners, all in the same town and range, may be recorded on this certificate.

	A	B	C	D	E	F	G	H	I	J	K	L	M
1													
2	6	5	4	3	2	1							
3													
4	7	8	9	10	11	12							
5													
6	10	17	16	15	14	13							
7													
8	19	20	21	22	23	24							
9													
10	30	29	28	27	26	25							
11													
12	31	32	33	34	35	36							
13													

A. Description of original monument and accessories and/or subsequent restoration:  
 (K10) Quarter corner common to Sections 25-26. 1849: Established by L.S. Seattles: North bet. 25&26...40.00 Set cedar qr. sec. post.  
 M. Pine 24 S85E 16, N. Pine 30 N35W 4. ... 80.00 Section corner. 1854: Examinations by A.B. Wood: Quarter corner M. Pine 30 N30W 5,  
 N. Pine 26 S85E 16.5.

B. Description of corner evidence found and/or method applied in restoring or reestablishing corner:


(K10) The original post was not recovered. Remonumented the corner at record bearing and distance from the remains of the original M. Pine 8Ts. Both are now stumps in an advanced state of decay, of proper size, no markings visible.

C. Description of monument for corner and accessories established to perpetuate locating the position of the corner:

- (K10) Set 1" IDx32" I. pipe with 4" alum.  
 HDNR cap. Blazed, scribed, and set  
 measuring nails in:  
 10" Spruce N11W 19.1' "1/4S NBT"  
 3" Spruce N43E 15.8' do  
 8" Spruce S26E 38.2' do  
 7" Balsam S19W 30.2' do  
 Set sq'd cedar post N44W 2.2'  
 Bearings are magnetic. Distances are to nail with tag.

Signed by Stephan J. Szyszkoski  
 Surveyor's Michigan License No. 33986

Date 5/29/03

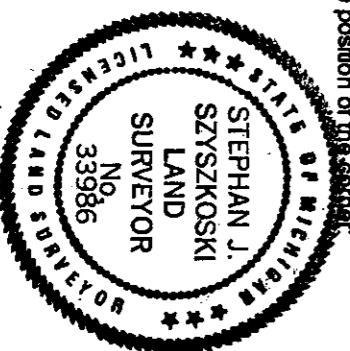

Register of Deeds Stamp & File Number