

**LAND CORNER RECORDATION CERTIFICATE**  
**Filing Requirement of Act 74, Mich. P.A. 1970**

For corners in

Iron \_\_\_\_\_

(County)

Located in:

Corner Code #

1. Public Land Survey	T	R	
	T	R	
	T	R	
	T	R	
2. Property Controlling in Section	S	36	T
	S	36	T
3. Miscellaneous Property in Sec.	S		T
	S		T

4. Lot No. \_\_\_\_\_, Recorded Plat \_\_\_\_\_  
 5. Private Claims \_\_\_\_\_

Apr 01 2003

I, Stephan J. Szyzkoski, in a field survey on \_\_\_\_\_, 20 \_\_\_\_\_ do hereby state that under requirements of P.A. 74, Michigan P.A. of 1970, the corner points mentioned in lines 1 and 2 above were in conformance with regulations and rules therefore as required in the current manual of survey instructions of the United States Department of the Interior, Bureau of Land Management or by a decree of a Court of Law and/or that the corner points mentioned in lines 3, 4 and 5 above were in conformance with the rules of the Michigan Board of Land Surveyors or by a Decree of a Court of Law, established, re-established, monumented, recovered, found as expressed below:

1	A	B	C	D	E	F	G	H	I	J	K	L	M
2	6	5	4	3	2	1							
3													
4	7	8	9	10	11	12							
5													
6	18	17	16	15	14	13							
7													
8	19	20	21	22	23	24							
9													
10	30	29	28	27	26	25							
11													
12	31	32	33	34	35	36							
13													

NOTE: Not more than 2 corners, all in the same town and range, may be recorded on this certificate.

A. Description of original monument and accessories and/or subsequent restoration:  
 (1-Sec. 36) West 1/16 corner between Sections 25 & 36. Not established in the original survey. Found no subsequent record.  
 (5-Sec. 36) North 1/16 corner, Section 36. Not established in the original survey. Found no subsequent record.


B. Description of corner evidence found and/or method applied in restoring or reestablishing corner:

(1-Sec. 36) Established the corner midway and on a line of mean true bearing between Section and Quarter corners 1315.67' west and east.  
 (5-Sec. 36) Established the corner midway and on a straight line between Quarter corner and Center of Section 1311.98' north and south. From the corner monumented, I found a 1 3/8" ID iron pipe, projecting 12", placed by persons unknown, 881W 25.0' distant.

C. Description of monument for corner and accessories established to perpetuate locating the position of the corner:

(1) Set 1"IDx32" I.pipe with 4" alum. MDMR cap. Blazed, scribed, and set measuring nails in:	(5) Set 1"IDx32" I.pipe with 4" alum. MDMR cap. Blazed, scribed, and set measuring nails in:
5" Balsam NOSE 50.05'	5" dbl Y. Birch N49W 37.45'
4" Cherry N50E 20.75'	7" Maple S79E 14.65'
4" Poplar S53W 6.60'	11" Spruce S03E 11.40'
4" Poplar N26W 18.55'	8" Y. Birch S85W 22.90'

Set squared spruce post adjacent. Bearings are magnetic. Distances are to nail with tag.

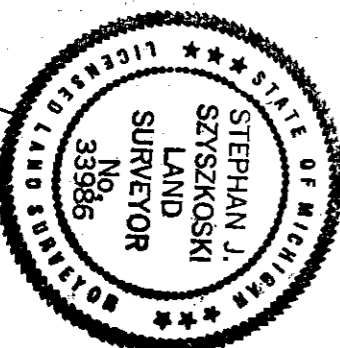

Signed by Stephan J. Szyzkoski  
 Surveyor's Michigan License No. 33986

Date 5/29/03

Register of Deeds Stamp & File Number