

LAND CORNER RECORDATION CERTIFICATE
Filing Requirement of Act 74, Mich. P.A. 1970

For corners in

Iron

(County)

Located In:

Corner Code #

1. Public Land Survey	T 45N R 32W	L12
	T R	
	T R	
	T R	
2. Property Controlling in Section	S 36 T 45N R 32W	9
	S T R	
	S T R	
3. Miscellaneous Property in Sec.	S T R	

4. Lot No. _____, Recorded Plat _____
 5. Private Claims _____

Apr 02 2003

I, Stephan J. Szyzskoski, in a field survey on _____ 20 _____ do hereby state that under requirements of P.A. 74, Michigan P.A. of 1970, the corner points mentioned in lines 1 and 2 above were in conformance with regulations and rules therefore as required in the current manual of survey instructions of the United States Department of the Interior, Bureau of Land Management or by a decree of a Court of Law and/or that the corner points mentioned in lines 3, 4 and 5 above were in conformance with the rules of the Michigan Board of Land Surveyors or by a Decree of a Court of Law, established, re-established, monumented, recovered, found as expressed below:


NOTE: Not more than 2 corners, all in the same town and range, may be recorded on this certificate.

	A	B	C	D	E	F	G	H	I	J	K	L	M
1													
2	6	5	4	3	2	1							
3													
4	7	8	9	10	11	12							
5													
6	10	17	16	15	14	13							
7													
8	19	20	21	22	23	24							
9													
10	30	29	28	27	26	25							
11													
12	31	32	33	34	35								
13													

A. Description of original monument and accessories and/or subsequent restoration:
 (12) Center of Section 36. Not established in the original survey. Found no subsequent record.
 (9-Sec. 36) East 1/16 corner, Section 36. Not established in the original survey. Found no subsequent record.

B. Description of corner evidence found and/or method applied in restoring or reestablishing corner:
 (12) Established the corner at the intersection of straight lines connecting opposite 1/4 corners. The corner position falls in a 8" dia. Balsam. Cut the tree and drove a 3/8" x 8" iron spike at the corner position on the stump.
 (9-Sec. 36) Established the corner midway and on a straight line between Quarter corner and Center of Section 1319.11' east and west. The corner falls on the top of a rock knob.

C. Description of monument for corner and accessories established to perpetuate locating the position of the corner:
 (12) Set 3/8"x8" iron spike in 8" Balsam stump, blazed, scribed, and set measuring nails in:
 4" B. Ash N73E 13.5' "C1/4 BT"
 13" Cedar S26E 16.9' do
 14" Cedar S83W 49.1' do
 7" Spruce N10W 42.5' do
 Sq'd a 3" B. Ash adjacent. Bearings are magnetic. Distances are to nail with tag #33986
 (9) Set 1/2"x12" rebar grouted into a 6" deep drill hole in bedrock and encased in a 1"IDx12" I. pipe with 4" alum. MDR cap. Made firm in a mound of rock. Blazed, scribed and set meas. nails in:
 15" Cedar N25E 13.7' "1/16S BT"
 4" Sugar S05W 18.6' do
 11" Sugar N65W 22.6' do
 6" Sugar N34W 22.9' do
 Set squared cedar post adjacent. Bearings are magnetic.

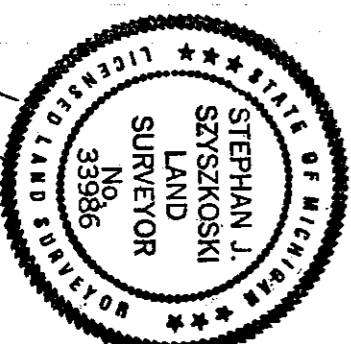

Signed by Stephan J. Szyzskoski Date 5/29/03
 Surveyor's Michigan License No. 33986

Register of Deeds Stamp & File Number