

LAND CORNER RECORDATION CERTIFICATE
Filing Requirement of Act 74, Mich. P.A. 1970

For corners in

Iron

Located in:

(County)

Corner Code #

1. Public Land Survey	T	R	
	T	R	
	T	R	
2. Property Controlling In Section	S	36	T
	S	36	T
3. Miscellaneous Property in Sec.	S		T
	S		T

4. Lot No. _____, Recorded Plat _____

11 Apr 02 2003
 10 May 05 2003

1. Stephan J. Szyzkoski in a field survey on 20 do hereby state that under requirements of P.A. 74, Michigan P.A. of 1970, the corner points mentioned in lines 1 and 2 above were in conformance with regulations and rules therefore as required in the current manual of survey instructions of the United States Department of the Interior, Bureau of Land Management or by a decree of a Court of Law and/or that the corner points mentioned in lines 3, 4 and 5 above were in conformance with the rules of the Michigan Board of Land Surveyors or by a Decree of a Court of Law, established, re-established, monumented, recovered, found as expressed below:

NOTE: Not more than 2 corners, all in the same town and range, may be recorded on this certificate.

1	A	B	C	D	E	F	G	H	I	J	K	L	M
2	6	5	4	3	2	1							
3													
4	7	8	9	10	11	12							
5													
6	18	17	16	15	14	13							
7													
8	19	20	21	22	23	24							
9													
10	30	29	28	27	26	25							
11													
12	31	32	33	34	35	36							
13													

A. Description of original monument and accessories and/or subsequent restoration in the original survey. Found no subsequent record. (10-Sec. 36) South 1/16 corner between Sections 35 and 36. Not established in the original survey. Found no subsequent record. (11-Sec. 36) Southwest 1/16 corner, Section 36. Not established in the original survey. Found no subsequent record.


B. Description of corner evidence found and/or method applied in restoring or reestablishing corner:

(10-Sec. 36) Established the corner midway and on a straight line between Section corner 1293.07' south and Quarter corner 1293.07' north.
 (11-Sec. 36) Established the corner at the intersection of straight lines connecting opposite 1/16 corners.

C. Description of monument for corner and accessories established to perpetuate locating the position of the corner:

(10) Set a 1"IDx32" I.pipe with 4" alum MDNR cap driven into broken rock and made firm with a mound of rock. Blazed, scribed, and set mess. nails in:	(11) Set 1"IDx36" I.pipe with 4" alum. MDNR cap. Blazed, scribed, and set measuring nails in:
6" Sugar N80E 30.9' "1/16S 87"	9" dbl Y.Birch N19E 0.6' "1/16S 87"
9" Sugar S01E 23.4' do	5" Spruce S05W 3.2' do
6" Sugar N80E 30.9' do	12" Cedar S49W 47.6' do
6" Sugar West 16.7' do	12" Hemlock N55W 34.5' do
7" Sugar N04W 31.7' do	

Bearings are magnetic. Distances are to nail with tag.

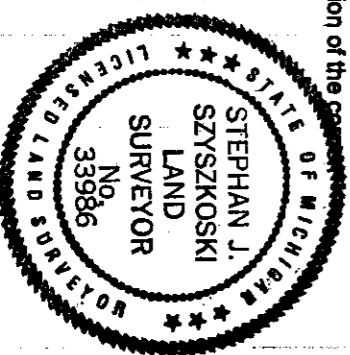

Signed by Stephan J. Szyzkoski
 Surveyor's Michigan License No. 33986

Date 5/29/03

For the Michigan Department of Natural Resources - Office of Land and Facilities