

**LAND CORNER RECORDATION CERTIFICATE**  
**Filing Requirement of Act 74, Mich. P.A. 1970**

For corners in

Iron

Located in:

(County)

Corner Code #

1. Public Land Survey	T 45N R 32W	K11
	T 45N R 32W	L11
	T ___ R ___	___
	T ___ R ___	___
2. Property Controlling in Section	S ___ T ___ R ___	___
	S ___ T ___ R ___	___
3. Miscellaneous Property in Sec.	S ___ T ___ R ___	___

4. Lot No. \_\_\_\_\_, Recorded Plat \_\_\_\_\_  
 5. Private Claims \_\_\_\_\_

Har 26 2003

1. Stephan J. Szyszkoski in a field survey on \_\_\_\_\_ 20 \_\_\_\_\_ do hereby state that under requirements of P.A. 74, Michigan P.A. of 1970, the corner points mentioned in lines 1 and 2 above were in conformance with regulations and rules therefore as required in the current manual of survey instructions of the United States Department of the Interior, Bureau of Land Management or by a decree of a Court of Law and for that the corner points mentioned in lines 3, 4 and 5 above were in conformance with the rules of the Michigan Board of Land Surveyors or by a Decree of a Court of Law; established, re-established, monumented, recovered, found as expressed below:

NOTE: Not more than 2 corners, all in the same town and range, may be recorded on this certificate.

	A	B	C	D	E	F	G	H	I	J	K	L	M
1													
2		6	5	4	3	2	1						
3													
4		7	8	9	10	11	12						
5													
6		18	17	16	15	14	13						
7													
8		19	20	21	22	23	24						
9													
10		30	29	28	27	26	25						
11													
12		31	32	33	34	35	36						
13													

Register of Deeds Stamp & File Number


A. Description of original monument and accessories and/or subsequent restoration: North between Secs. 35&36...80.00 Set cedar post cor. (L11) Corner common to Sections 25-26-35-36. 1849: Established by T.B. Searles; North between Secs. 35&36...80.00 Set cedar post cor. of Sec. 25,26,35,36. Hemlock 10 S31E 31, W.Pine 28 N75W 48. 1854: Examination by A.B. Wood: W.Pine 24 N72W 46, Hemlock 12 S33E 31.5. Monumented and recorded in 1992 by K.L.Sackett: Found white pine stump N33W 48 links ... near Int. of old blazed pine. Set 1"IDx36" iron pipe with 4" aluminum cap. 6" spruce N81W 17.8', 8" maple S40W 50.8', 7" maple N35E 8.1', 3" maple S18E 10.8'.  
 (L11) Quarter corner common to Sections 25-36. 1849: Established by Z.B. Searles: West...39.98 Set quarter section post. Ironwood 6 South 13, Lynn 20 N25W 19...79.96 Section corner. 1992: Monumented and recorded by K.L.Sackett, RLS: Restored midway and on line. Set 1"IDx36" iron pipe with 4" aluminum cap. 8" Sugar S31W 2.1', 6" Sugar N53W 7.1', 6" Sugar S09E 8.3, 18" Sugar N27E 19.7', 1 1/4" ID pipe NOTE 31.05'

B. Description of corner evidence found and/or method applied in restoring or reestablishing corner:

(L11) The original post and accessories were not recovered. Recovered but did not accept the 1992 monument. It was found substantially as recorded, S6W 84.5' from the corner position subsequently monumented. The undersigned believes that the W.Pine stump noted in the 1992 record was not the original bearing tree, which, in any case, is noted by Searles as being N73W from the corner, not N33W. I destroyed the 1992 corner and reestablished the corner by double proportionate measurement to the original record between corners 5265.34' W (80.00 ch R), 2624.56' N (40.00 R), 2624.56' S (40.00 R), and 2631.34'E (39.98 R).

(L11) The original post and accessories were not recovered. Recovered but did not accept the 1992 monument as its location is based on what I believe to be an erroneous (and now destroyed) corner position 1/2 west at K11. The 1 1/4" iron pipe noted in the 1992 record was recovered and found to be in substantial accord with the original record between M11 and the 2003 reestablishment of K11. Therefore, I accepted the location of the 1 1/4" pipe as the best available evidence of the position of the original corner. The 1992 NRTs were defaced. The cap of the 1992 monument was removed and the pipe itself was driven to 4" below the ground surface. It could not be removed due to tree roots and frozen ground. Accessories established to perpetuate locating the position of the corner.

(L11) Set 1"IDx32" I. pipe with 4" alum. MONR cap. Blazed, scribed, and set measuring nails in:	(L11) Found 1 1/4" ID I. pipe. Blazed, scribed, and set measuring nails in:
8" Sugar N32E 5.2'	8" Sugar N84E 20.3'
8" Sugar N32E 5.2'	16" Sugar S22E 13.7'
5" Sugar N58E 20.8'	15" Sugar S26W 7.1'
9" Maple S20E 43.5'	4" Sugar N54W 4.4'
15" W.Pine N78W 93.0'	Set squared cedar post adjacent.
	Bearings are magnetic. Distances are to nail with tag #33986

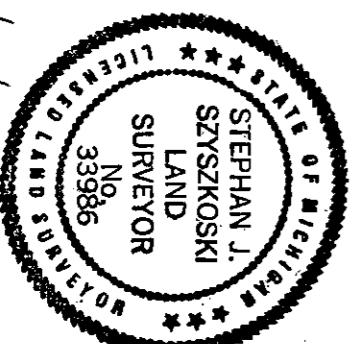

Signed by Stephan J. Szyszkoski  
 Surveyor's Michigan License No. 33986

Date 5/29/03