

# SURVEY & REMONUMENTATION

FORM NO. 985-A



Stock No. 26273

MAR 19 1997

## COMMISSION

### LAND CORNER RECORDATION CERTIFICATE Filing Requirement of Act 74, Mich. P.A. 1970

For corners in

Located In: Iron (County) Corner Code # \_\_\_\_\_

1. Public Land Survey T 45N R 35W M-2  
~~T 45N R 34W~~ A-2  
 T \_\_\_\_\_ R \_\_\_\_\_  
 T \_\_\_\_\_ R \_\_\_\_\_

2. Property Controlling in Section S \_\_\_\_\_ T \_\_\_\_\_ R \_\_\_\_\_  
 S \_\_\_\_\_ T \_\_\_\_\_ R \_\_\_\_\_

3. Miscellaneous Property in Sec. S \_\_\_\_\_ T \_\_\_\_\_ R \_\_\_\_\_  
 S \_\_\_\_\_ T \_\_\_\_\_ R \_\_\_\_\_

IRON COUNTY  
MICHIGAN  
RECEIVED FOR RECORD

96 DEC 23 AM 8:54  
L.C. Records L. 7, P. 29  
*Gary L. Pisoni*  
REGISTERED LAND SURVEYOR

Register of Deeds Stamp & File Number

4. Lot No. \_\_\_\_\_, Recorded Plat \_\_\_\_\_  
 5. Private Claims \_\_\_\_\_

Quarter Corner S.1, T45N R35W, S-6, T45N R34W

Gary L. Pisoni, in a field survey on October 11, 19 96 do hereby state that under requirements of P.A. 74, Michigan P.A. of 1970, the corner points mentioned in lines 1 and 2 above were in conformance with regulations and rules therefore as required in the current manual of survey instructions of the United States Department of the Interior, Bureau of Land Management or by a decree of a Court of Law and/or that the corner points mentioned in lines 3, 4 and 5 above were in conformance with the rules of the Michigan Board of Land Surveyors or by a Decree of a Court of Law; established, re-established, monumented, recovered, found as expressed below:

	A	B	C	D	E	F	G	H	I	J	K	L	M
1													
2	6		5		4		3		2		1		
3													
4	7		8		9		10		11		12		
5													
6	18		17		16		15		14		13		
7													
8	19		20		21		22		23		24		
9													
10	30		29		28		27		26		25		
11													
12	31		32		33		34		35		36		
13													

NOTE: Not more than 2 corners, all in the same town and range, may be recorded on this certificate.

A. Description of original monument and accessories and/or subsequent restoration:

Original corner established by William Burt, U.S. Deputy Surveyor on September 17, 1846.  
 Original corner: Sugar Post  
 Original bearing trees:

Yellow Birch 12" N 39° E 11 links ( 7.26 feet)  
 Hemlock 16" N 83° W 29 links (19.14 feet)

In 1969, Donald D. Lappala, R.L.S., set a 2" dia. X 5 feet long, concrete filled galvanized iron pipe with brass tablet from a found 1 1/2" x 36" iron pipe and evidence from original bearing trees as described above.

Recorded in Land Corner Certificate L. 3, Page 78 on March 11, 1970.

1969 Bearing Trees:

Sugar Maple 3" N 14° W 44.5 feet  
 Sugar Maple 4" S 85° E 25.5 feet  
 Sugar Maple 14" S 72° W 48.3 feet


PEER GROUP APPROVED  
*Gary L. Pisoni 12-21-96*  
 COUNTY REPRESENTATIVE

B. Description of corner evidence found and/or method applied in restoring or reestablishing corner:

Found the monument and bearing trees as described above.

Sugar Maple 8" N 13° W 44.38 feet  
 Sugar Maple 8" S 83° W 25.41 feet  
 Sugar Maple 20" S 74° W 48.40 feet  
 Wood Sign Post N 13° W 0.60 feet

Corner Record Research on file with County Representative.

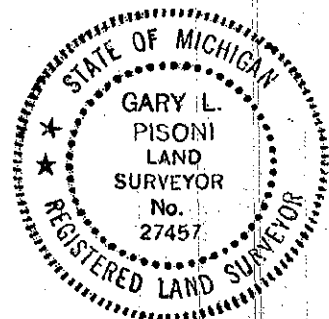

C. Description of monument for corner and accessories established to perpetuate locating the position of the corner:

From the above described brass cap monument, I established the following new blazed and scribed bearing tree: (all measurements taken to a nail in side of tree)

Sugar Maple 8" S 03° W 32.39 feet  
 Steel Sign Post 6' S 64° E 1.70 feet

#96-07  
 Signed by *Gary L. Pisoni*

Date 12-10-96

Surveyor's Michigan License No. 27457

L. 7 P. 29