



SURVEY & REMONUMENTATION

Stock No. 26273

MAR 19 1997

LAND CORNER RECORDATION CERTIFICATE Filing Requirement of Act 74, Mich. P.A. 1970

For corners in **COMMISSION**

IRON COUNTY
MICHIGAN
RECEIVED FOR RECORD

96 DEC 23 AM 8:58

L.C. Records L. 7, P. 32

Robert J. Pisoni
REGISTERED LAND SURVEYOR

Iron (County)	Located In:	Corner Code #
1. Public Land Survey	T 46N R 34W	B-13
	T 45N R 34W	B-1
	T _____ R _____	_____
	T _____ R _____	_____
2. Property Controlling in Section	S _____ T _____ R _____	_____
	S _____ T _____ R _____	_____
3. Miscellaneous Property in Sec.	S _____ T _____ R _____	_____
	S _____ T _____ R _____	_____

Register of Deeds Stamp & File Number

4. Lot No. _____, Recorded Plat _____
5. Private Claims _____

Quarter Corner S.31, T46N R34W
S.6, T45N R34W

I, Gary L. Pisoni, in a field survey on October 18, 19 96 do hereby state that under requirements of P.A. 74, Michigan P.A. of 1970, the corner points mentioned in lines 1 and 2 above were in conformance with regulations and rules therefore as required in the current manual of survey instructions of the United States Department of the Interior, Bureau of Land Management or by a decree of a Court of Law and /or that the corner points mentioned in lines 3, 4 and 5 above were in conformance with the rules of the Michigan Board of Land Surveyors or by a Decree of a Court of Law; established, re-established, monumented, recovered, found as expressed below:

NOTE: Not more than 2 corners, all in the same town and range, may be recorded on this certificate.

1	A	B	C	D	E	F	G	H	I	J	K	L	M
2		6		5		4		3		2		1	
3													
4		7		8		9		10		11		12	
5													
6		18		17		16		15		14		13	
7													
8		19		20		21		22		23		24	
9													
10		30		29		28		27		26		25	
11													
12		31		32		33		34		35		36	
13													

A. Description of original monument and accessories and/or subsequent restoration:

Original corner established by William Burt, U.S. Deputy Surveyor on September 21, 1846.

Original corner: Sugar Post

Original bearing trees:

Yellow Birch	22"	N 56° E	28 links (18.48 feet)
Yellow Birch	9"	N 58° W	17 links (11.22 feet)

B. Description of corner evidence found and/or method applied in restoring or reestablishing corner:

No original corner evidence found. Found a 6" dia. by 4 feet tall wood post marking corner position. G.L.O. distances check good East and West along Town Line to other GLO corners. I accept wood post as the best available evidence for restoring the corner position.


PEER GROUP APPROVED
Gary L. Pisoni 12-11-96
COUNTY REPRESENTATIVE

Corner Record Research on file with County Representative.

C. Description of monument for corner and accessories established to perpetuate locating the position of the corner:

At the corner position, I set a 3/4" outside diameter by 3 feet long aluminum rod monument with a 3" cast aluminum cap, stamped to read: Iron County Remonumentation, T46N, R34W, 1/4, S-31, S-6, T45N, 1996, RLS-27457 from which I established the following new blazed and scribed bearing trees: (all measurements taken to a nail in side of tree)

Sugar Maple	6"	N 44° E	15.98 feet
Hemlock	10"	S 21° E	21.25 feet
Yellow Birch	7"	S 41° W	32.61 feet
Sugar Maple	6"	N 57° W	28.81 feet
Steel Sign Post	6'	S 38° W	0.80 feet

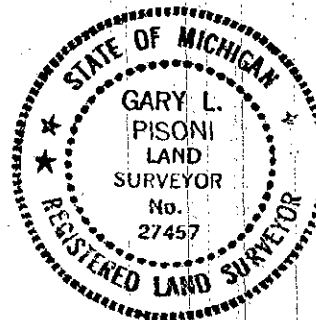

#96-10
Signed by Gary L. Pisoni
Surveyor's Michigan License No. 27457

Date 12-10-96

L. 7 P. 32