

SURVEY & REMONUMENTATION

FORM NO. 985-A



Stock No. 26273

MAR 19 1997

COMMISSION

LAND CORNER RECORDATION CERTIFICATE Filing Requirement of Act 74, Mich. P.A. 1970

For corners in

Iron
(County)

Located in:

Corner Code #

- | | | |
|------------------------------------|---------------------------|------------|
| 1. Public Land Survey | T <u>45N</u> R <u>34W</u> | <u>E-3</u> |
| | T _____ R _____ | _____ |
| | T _____ R _____ | _____ |
| | T _____ R _____ | _____ |
| 2. Property Controlling in Section | S _____ T _____ R _____ | _____ |
| | S _____ T _____ R _____ | _____ |
| 3. Miscellaneous Property in Sec. | S _____ T _____ R _____ | _____ |
| | S _____ T _____ R _____ | _____ |

IRON COUNTY
MICHIGAN
RECEIVED FOR RECORD

96 DEC 23 AM 8:58

L.C. Records 27, p. 33

Gilbert Stebbins
REGISTERED DEEDS

Register of Deeds Stamp & File Number

4. Lot No. _____, Recorded Plat _____
5. Private Claims _____

Section Corner 4, 5, 8 & 9, T45N R34W

I, Gary L. Pisoni, in a field survey on October 18, 1996 do hereby state that under requirements of P.A. 74, Michigan P.A. of 1970, the corner points mentioned in lines 1 and 2 above were in conformance with regulations and rules therefore as required in the current manual of survey instructions of the United States Department of the Interior, Bureau of Land Management or by a decree of a Court of Law and /or that the corner points mentioned in lines 3, 4 and 5 above were in conformance with the rules of the Michigan Board of Land Surveyors or by a Decree of a Court of Law; established, re-established, monumented, recovered, found as expressed below:

NOTE: Not more than 2 corners, all in the same town and range, may be recorded on this certificate.

	A	B	C	D	E	F	G	H	I	J	K	L	M
1													
2	6		5		4		3		2		1		
3					•								
4	7		8		9		10		11		12		
5													
6	18		17		16		15		14		13		
7													
8	19		20		21		22		23		24		
9													
10	30		29		28		27		26		25		
11													
12	31		32		33		34		35		36		
13													

A. Description of original monument and accessories and/or subsequent restoration:

Original corner established by Guy H. Carleton, U.S. Deputy Surveyor on July 20, 1851.

Original corner: Post

Original bearing trees:

Tamarack	10"	S 74° E	11 links (7.26 feet)
Yellow Birch	10"	N 60° W	28 links (18.48 feet)

On October 10, 1953, Wickman & Peryam, Northern Paper Mills, set a 2" dia brass capped pipe monument from a found wood post and evidence from original bearing trees as described above. Recorded in Land Corner Certificate L. 2, Page 65 on 8/27/1976.

1953 bearing trees:

Cedar	10"	N 86° W	35 links (23.10 feet)
Ash	18"	S 62° E	52.5 links (34.65 feet)

B. Description of corner evidence found and/or method applied in restoring or reestablishing corner:

Found the monument and bearing trees as described above.

Cedar	16"	N 76° W	23.02 feet
Ash	18"	S 62° E	34.53 feet


Corner Record Research on file with County Representative.

C. Description of monument for corner and accessories established to perpetuate locating the position of the corner:

At the above described 2" brass cap monument, I established the following new blazed and scribed bearing trees: (all measurements taken to a nail in side of tree)

Yellow Birch	15"	N 08° W	17.05 feet
Red Maple	12"	N 61° E	15.62 feet
Ash	5"	S 42° E	16.13 feet
Steel Sign Post	6'	SOUTH	0.76 feet

PEER GROUP APPROVED
Gary L. Pisoni 12-11-96
COUNTY REPRESENTATIVE

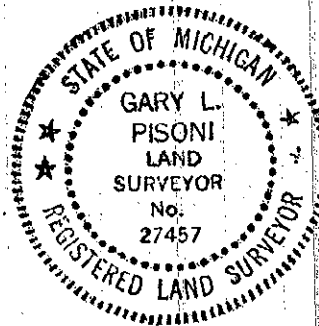

96-11

Signed by Gary L. Pisoni

Date 12-10-96

Surveyor's Michigan License No. 27457

FORM APPROVED BY MICHIGAN STATE BOARD OF PROFESSIONAL SURVEYORS, JAN. 28, 1971
REVISED MAY 14, 1975
REVISED JAN., 1983
REVISED OCT., 1995

L.C. 27, p. 33