

**SURVEY &
REMONUMENTATION**

FORM NO. 985-A



MAR 19 1997

Stock No. 26273

COMMISSION

LAND CORNER RECORDATION CERTIFICATE
Filing Requirement of Act 74, Mich. P.A. 1970

For corners in

Iron
(County)

Located In:

Corner Code #

1. Public Land Survey

T 46N R 34W

G-13

~~T 46N R 34W~~

~~G-13~~

T _____ R _____

T _____ R _____

2. Property Controlling
in Section

S _____ T _____ R _____

S _____ T _____ R _____

3. Miscellaneous
Property in Sec.

S _____ T _____ R _____

S _____ T _____ R _____

4. Lot No. _____, Recorded Plat _____

5. Private Claims _____

Section Corner 33 & 34, T46N R34W
4 & 3, T45N R34W

I, Gary L. Pisoni, in a field survey on October 19, 1996 do hereby state that under requirements of P.A. 74, Michigan P.A. of 1970, the corner points mentioned in lines 1 and 2 above were in conformance with regulations and rules therefore as required in the current manual of survey instructions of the United States Department of the Interior, Bureau of Land Management or by a decree of a Court of Law and /or that the corner points mentioned in lines 3, 4 and 5 above were in conformance with the rules of the Michigan Board of Land Surveyors or by a Decree of a Court of Law; established, re-established, monumented, recovered, found as expressed below:

NOTE: Not more than 2 corners, all in the same town and range, may be recorded on this certificate.

A. Description of original monument and accessories and/or subsequent restoration:

Original corner established by Austin Burt, U.S. Deputy Surveyor on September 18, 1846.

Original corner: Hemlock Post

Original bearing trees:

Fir	8"	N 79° E	26 Links (17.16 feet)
Fir	8"	N 58 1/2° W	65 Links (42.90 feet)

Original Subdivison established by Guy H. Carleton, U.S. Deputy Surveyor on July 12, 1851.

Original bearing trees:

Yellow Birch	12"	S 23° W	57 Links (37.62 feet)
White Pine	28"	S 75° E	35 Links (23.10 feet)

B. Description of corner evidence found and/or method applied in restoring or reestablishing corner:

No original corner evidence found.

Found a 4" x 4" rotted post marking corner position. G.L.O. distance checks good East and West along Town line to other GLO corners.

I accept the wood post as the best available evidence for restoring the corner position.

Corner Record Research on file with County Representative.

C. Description of monument for corner and accessories established to perpetuate locating the position of the corner:

At the corner position, I set a 3/4" outside diameter by 3 feet long aluminum rod monument with a 3" cast aluminum cap, stamped to read: Iron County Remonumentation, T46N, R34W, S-33, S-34, S-4, S-3, T45N, 1996, RLS-27457 from which I established the following new blazed and scribed bearing trees: (all measurements taken to a nail in side of tree)


Hemlock	15"	S 64° W	18.31 feet
Hemlock	16"	N 53° W	10.71 feet
Hemlock	12"	N 48° E	28.10 feet
Sugar Maple	6"	S 61° E	22.62 feet
Steel Sign Post	6"	S 80° W	1.40 feet

IRON COUNTY
MICHIGAN
RECEIVED FOR RECORD
96 DEC 23 AM 9:04
L.C. Records L.7, P. 48
Gary L. Pisoni
REGISTERED LAND SURVEYOR

Register of Deeds Stamp & File Number

1	A	B	C	D	E	F	G	H	I	J	K	L	M
2		6		5		4		3		2		1	
3													
4		7		8		9		10		11		12	
5													
6		18		17		16		15		14		13	
7													
8		19		20		21		22		23		24	
9													
10		30		29		28		27		26		25	
11													
12		31		32		33		34		35		36	
13													

PEER GROUP APPROVED
Gary L. Pisoni 12-11-96
COUNTY REPRESENTATIVE

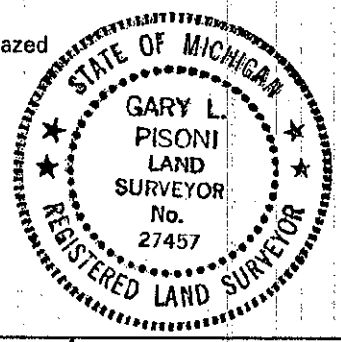

#96-26
Signed by *Gary L. Pisoni*

Date 12-10-96

Surveyor's Michigan License No. 27457

L.7 P.48