



SURVEY & REMONUMENTATION

Stock No. 26273

MAR 19 1997

COMMISSION

LAND CORNER RECORDATION CERTIFICATE
Filing Requirement of Act 74, Mich. P.A. 1970

For corners in

Iron <small>(County)</small>	Located In:	Corner Code #
1. Public Land Survey	T <u>45N</u> R <u>34W</u>	<u>G-3</u>
	T _____ R _____	_____
	T _____ R _____	_____
	T _____ R _____	_____
2. Property Controlling in Section	S _____ T _____ R _____	_____
	S _____ T _____ R _____	_____
3. Miscellaneous Property in Sec.	S _____ T _____ R _____	_____
	S _____ T _____ R _____	_____

IRON COUNTY
MICHIGAN
RECEIVED FOR RECORD

96 DEC 23 AM 9:00
L.C. Records L. 7, P. 38
Richard L. Pisoni
REGISTERED LAND SURVEYOR

Register of Deeds Stamp & File Number

4. Lot No. _____, Recorded Plat _____
5. Private Claims _____

Section Corner 3, 4, 9 & 10, T45N R34W

I, Gary L. Pisoni, in a field survey on October 19, 1996 do hereby state that under requirements of P.A. 74, Michigan P.A. of 1970, the corner points mentioned in lines 1 and 2 above were in conformance with regulations and rules therefore as required in the current manual of survey instructions of the United States Department of the Interior, Bureau of Land Management or by a decree of a Court of Law and /or that the corner points mentioned in lines 3, 4 and 5 above were in conformance with the rules of the Michigan Board of Land Surveyors or by a Decree of a Court of Law; established, re-established, monumented, recovered, found as expressed below:

	A	B	C	D	E	F	G	H	I	J	K	L	M
1													
2		6		5			4		3		2		1
3													
4		7		8			9		10		11		12
5													
6		18		17			16		15		14		13
7													
8		19		20			21		22		23		24
9													
10		30		29			28		27		26		25
11													
12		31		32			33		34		35		36
13													

NOTE: Not more than 2 corners, all in the same town and range, may be recorded on this certificate.

A. Description of original monument and accessories and/or subsequent restoration:

Original corner established by Guy H. Carleton, U.S. Deputy Surveyor on July 19, 1851.

Original corner: Wood Post

Original bearing trees:

Hemlock	16"	N 75° E	36 links (23.76 feet)
Sugar	12"	S 75° W	48 links (31.68 feet)

On October 10, 1953, Wickman & Peryam, Northern Paper Mills, set a 2" dia. iron pipe with brass cap from a wooden post and original bearing trees as described above.

1953 bearing trees:

Sugar Maple	14"	S 49° W	57 links (37.62 feet)
Sugar Maple	8"	N 18° E	63 links (41.58 feet)

B. Description of corner evidence found and/or method applied in restoring or reestablishing corner:

Found the monument and bearing trees as described above, set by Northern Paper Mills as well as a wood post next to corner. Monument in poor condition. Replaced monument as described below.

Corner Record Research on file with County Representative.


C. Description of monument for corner and accessories established to perpetuate locating the position of the corner:

At the corner position, I set a 3/4" outside diameter by 3 feet long aluminum rod monument with a 3" cast aluminum cap, stamped to read: Iron County Remonumentation, T45N, R34W, S-4, S-3, S-9, S-10, 1996, RLS-27457 from which I established the following new blazed and scribed bearing trees: (all measurements taken to a nail in side of tree)

Sugar Maple	6"	S 80° E	13.85 feet
Sugar Maple	9"	S 01° E	38.11 feet
Sugar Maple	9"	N 75° W	46.54 feet
Sugar Maple	6"	N 16° W	6.08 feet
Steel Sign Post	6'	N 54° E	0.80 feet

PEER GROUP APPROVED

Iron County Peer Group 12-11-96
COUNTY REPRESENTATIVE

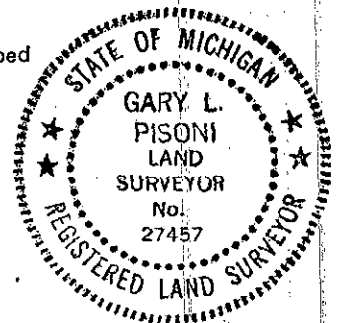

#96-16
Signed by *Gary L. Pisoni* Date 12-10-96
Surveyor's Michigan License No. 27457

L. 7 P. 38