

**SURVEY & REMONUMENTATION**

FORM NO. 985-A



MAR 19 1997

Stock No. 26273

**COMMISSION**

**LAND CORNER RECORDATION CERTIFICATE**  
Filing Requirement of Act 74, Mich. P.A. 1970

For corners in

<u>Iron</u> (County)	Located in:	Corner Code #
1. Public Land Survey	T 46N R 34W	K-13
	<del>T 45N R 34W</del>	<del>K-1</del>
	T _____ R _____	_____
	T _____ R _____	_____
2. Property Controlling in Section	S _____ T _____ R _____	_____
	S _____ T _____ R _____	_____
3. Miscellaneous Property in Sec.	S _____ T _____ R _____	_____
	S _____ T _____ R _____	_____

IRON COUNTY MICHIGAN  
RECEIVED FOR RECORD  
96 DEC 23 AM 9:04  
*L.C. Records L. 7, P. 49*  
*Gilbert Pisoni*  
REGISTERED LAND SURVEYOR

Register of Deeds Stamp & File Number

4. Lot No. \_\_\_\_\_, Recorded Plat \_\_\_\_\_  
5. Private Claims \_\_\_\_\_

Section Corner 35 & 36, T46N R34W  
2 & 1, T45N R34W

I, Gary L. Pisoni, in a field survey on October 19, 19 96 do hereby state that under requirements of P.A. 74, Michigan P.A. of 1970, the corner points mentioned in lines 1 and 2 above were in conformance with regulations and rules therefore as required in the current manual of survey instructions of the United States Department of the Interior, Bureau of Land Management or by a decree of a Court of Law and /or that the corner points mentioned in lines 3, 4 and 5 above were in conformance with the rules of the Michigan Board of Land Surveyors or by a Decree of a Court of Law; established, re-established, monumented, recovered, found as expressed below:

A	B	C	D	E	F	G	H	I	J	K	L	M
1												
2	6	5	4	3	2	1						
3												
4	7	8	9	10	11	12						
5												
6	18	17	16	15	14	13						
7												
8	19	20	21	22	23	24						
9												
10	30	29	28	27	26	25						
11												
12	31	32	33	34	35	36						
13												

NOTE: Not more than 2 corners, all in the same town and range, may be recorded on this certificate.

A. Description of original monument and accessories and/or subsequent restoration:

Original corner established by Austin Burt, U.S. Deputy Surveyor on September 18, 1846.  
Original corner: Tamarack Post

Original bearing trees:  
Tamarack 7" N 27° E 20 Links (13.20 feet)  
Tamarack 6" N 49° W 74 Links (48.84 feet)


Original Subdivision established by Guy H. Carleton, U.S. Deputy Surveyor on July 12, 1851.

Original bearing trees:  
Tamarack 6" S 09° W 43 Links (28.38 feet)  
Spruce 6" S 72° 30' E 47 Links (31.02 feet)

In 1932, B.G. Buell found 4 bearing tree stumps and set wood post.  
In 1953, Wickman found Buell's post and set a 1" dia. iron pipe with Northern Paper Mills brass cap

1953 bearing trees:  
Tamarack 4" N 19° E 51.5 Links (33.99 feet)  
Tamarack 4" S 38° W 18.3 Links (12.08 feet)

PEER GROUP APPROVED  
*Iron Gary L. Pisoni 12-11-96*  
COUNTY REPRESENTATIVE

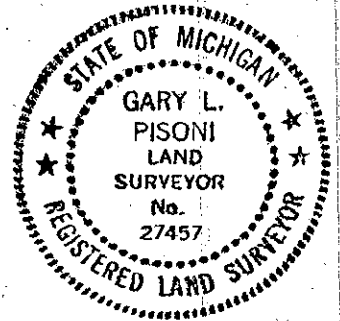

B. Description of corner evidence found and/or method applied in restoring or reestablishing corner:

Found monument and bearing trees as described above.  
Tamarack 6" N 18° E 34.31 feet  
Tamarack 7" S 42° W 12.35 feet

Corner Record Research on file with County Representative.

C. Description of monument for corner and accessories established to perpetuate locating the position of the corner:

Blazed and scribed the following new bearing trees: (all measurements taken to a nail in side of tree)  
Black Spruce 6" S 26° E 7.18 feet  
Black Spruce 7" N 13° W 22.54 feet  
Steel Sign Post 6' South 0.60 feet

#96-27  
Signed by Gary L. Pisoni Date 12-10-96

Surveyor's Michigan License No. 27457

*L. 7 P. 49*