LAND CORNER RECORDATION CERTIFICATE
Filing Requirement of Act 74, Mich. P.A. 1970 as Amended

For corners in

Iron (County)

	Located In:		Corner Code #
1. Public Land Survey		T 45N R 34W	G5
		T R	
		T R	
	S	T R	
2. Property Controlling	S 16	T 45N R 34W	16
in Section	S	T R	
3. Miscellaneous	S	T R	
Property in Sec.	S	T R	

Register of Deeds Stamp & File Number _____

4. Lot No. _____ , Recorded Plat_____

5. Private Claims

16 Feb 19 2004
G5 Feb 17 2004

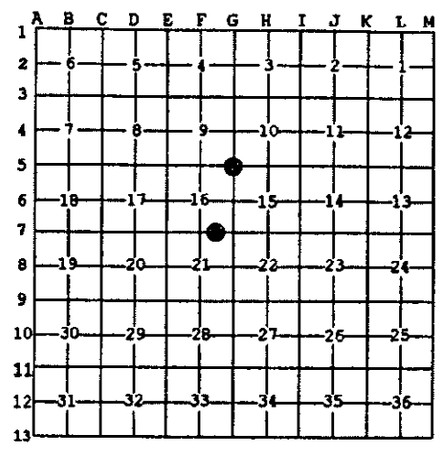

I, Stephan J. Szyszkoski, in a field survey on _____, 20 ____ do hereby state that under requirements of P.A. 74, Michigan P.A. of 1970, the corner points mentioned in lines 1 and 2 above were in conformance with regulations and rules therefore as required in the current manual of survey instructions of the United States Department of the Interior, Bureau of Land Management or by a decree of a Court of Law and /or that the corner points mentioned in lines 3, 4 and 5 above were in conformance with the rules of the Michigan Board of Land Surveyors or by a Decree of a Court of Law; established, re-established, monumented, recovered, found as expressed below:

NOTE: Not more than 2 corners, all in the same town and range, may be recorded on this certificate.

A. Description of original monument and accessories and/or subsequent restoration:

(G5) Corner common to Sections 9-10-15-16. 1974: Reestablished by A.O.Enger, RLS. Set 1"IDx36" I.pipe with 4" aluminum cap. Red Maple 13 N65W 13.0', Red Maple 16 N33E 29.2', Sugar Maple 8 S71E 14.1'.
(16-Sec. 16) East 1/16 corner between Sections 16 and 21. 1974: Established by A.O.Enger RLS. Set 1"IDx36" I.pipe with 3.5" aluminum cap. W.Spruce 11 N80E 14.1', Sugar Maple 6 N02E 18.1'.

B. Description of corner evidence found and/or method applied in restoring or reestablishing corner:

(G5) Found and accepted the 1974 monument, in good condition, and at record bearing and distance from the 1974 NBTs, recovered as follows: The R.Maple NE is now a stump, the R.Maple NW and the Sugar SE are in good condition.
(16-Sec. 16) Found and accepted the 1974 monument in accord with the record and at substantial record bearing and distance from the two 1974 BTs, recovered in good condition.

C. Description of monument for corner and accessories established to perpetuate locating the position of the corner:

(G5) Found 1"ID I.pipe with alum. MDNR cap. Blazed, scribed, and set measuring nails in:
7" Sugar N67E 19.3' "S10 NBT"
8" Sugar S25E 14.65' "S15 NBT"
Set nails in the 1974 NBTS:
10" Sugar S72E 14.4' with old blaze
15" R.Maple N60W 13.5' do
Bearings are magnetic. Distances are to nail with tag. Sq'd and scribed cedar post adjacent.

(16) Found 1"ID I.pipe with alum. MDNR cap. Blazed, scribed, and set measuring nails in:
4" Sugar S50E 9.95' "1/16S BT"
6" Sugar S62W 25.10' do
Set nails/tags in the 1974 BTs:
6" Sugar N08E 18.4' old blazes
10" W.Spruce N80E 13.9' do
Bearings are magnetic. Distances are to nail with tag.

STATE OF MICHIGAN
STEPHAN J. SZYSZKOSKI
LAND SURVEYOR
No. 33986
LICENSED LAND SURVEYOR

Signed by Stephan J. Szyszkoski Date 5/19/04

Surveyor's Michigan License No. 33986

For the Michigan Department of Natural Resources, Office of Land and Facilities

FORM APPROVED BY MICHIGAN STATE BOARD OF PROFESSIONAL SURVEYORS, JAN. 28, 1971
Revised May 14, 1975
Revised Jan., 1983
Rervised Oct., 1995