

**LAND CORNER RECORDATION CERTIFICATE**  
**Filing Requirement of Act 74, Mich. P.A. 1970 as Amended**

For corners in

<u>Iron</u> (County)	Located In:	Corner Code #	
1. Public Land Survey	T ___ R ___	_____	
	T ___ R ___	_____	
	T ___ R ___	_____	
2. Property Controlling in Section	S ___ T ___ R ___	_____	
	S 21 T 45N R 34W	9	
	S 21 T 45N R 34W	13	
3. Miscellaneous Property in Sec.	S ___ T ___ R ___	_____	
	S ___ T ___ R ___	_____	
4. Lot No. _____, Recorded Plat _____			
5. Private Claims			

Register of Deeds Stamp & File  
Number

	A	B	C	D	E	F	G	H	I	J	K	L	M
1													
2	6		5		4		3		2		1		
3													
4	7		8		9		10		11		12		
5													
6	18		17		16		15		14		13		
7													
8	19		20		21		22		23		24		
9													
10	30		29		28		27		26		25		
11													
12	31		32		33		34		35		36		
13													

May 04 2004

I, Stephan J. Szyszkoski, in a field survey on \_\_\_\_\_, 20 \_\_\_\_ do hereby state that under requirements of P.A. 74, Michigan P.A. of 1970, the corner points mentioned in lines 1 and 2 above were in conformance with regulations and rules therefore as required in the current manual of survey instructions of the United States Department of the Interior, Bureau of Land Management or by a decree of a Court of Law and /or that the corner points mentioned in lines 3, 4 and 5 above were in conformance with the rules of the Michigan Board of Land Surveyors or by a Decree of a Court of Law; established, re-established, monumented, recovered, found as expressed below:

**NOTE: Not more than 2 corners, all in the same town and range, may be recorded on this certificate.**

A. Description of original monument and accessories and/or subsequent restoration:


- (9-Sec. 21) East 1/16 corner, Section 21. Not established in the original survey.
- (13-Sec. 21) Southeast 1/16 corner, Sec. 21. Not established in the original survey.

B. Description of corner evidence found and/or method applied in restoring or reestablishing corner:

- (9-Sec. 21) Established the corner midway and on a straight line between Center of Section 21 1320.30' West and G8 1320.30' East.
- (13-Sec. 21) Established the corner at the intersection of straight lines connecting opposite 1/16 corners.

C. Description of monument for corner and accessories established to perpetuate locating the position of the corner:

- |  |  |
|--|--|
| (9) Set 1"IDx32" I.pipe with 4" alum.<br>MDNR cap. Blazed, scribed, and set<br>measuring nails in:<br>6" Sugar S78E 2.35'                      "1/16 BT"<br>7" Sugar S24W 17.4'                      do<br>5" Sugar N54W 3.64'                      do<br>8" Sugar N04W 28.7'                      do<br>Bearings are magnetic. Distances are to<br>nail with tag. | (13) Set 1"IDx32" I.pipe with 4" alum.<br>MDNR cap. Blazed, scribed, and set<br>measuring nails in:<br>5" Sugar N50E 21.45'                      "1/16S BT"<br>8" Maple in clump S60E 12.4'                      do<br>6" Y.Birch S70W 5.65'                      do<br>4" Sugar N25W 11.74'                      do<br>Bearings are magnetic. Distances are to<br>nail with tag. Set sq'd cedar post<br>adjacent. |
|--|--|

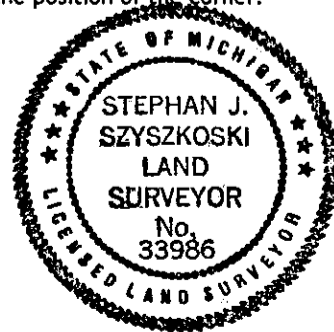

Signed by Stephan J. Szyszkoski  
 Surveyor's Michigan License No. 33986

Date 5/19/04