LAND CORNER RECORDATION CERTIFICATE
Filing Requirement of Act 74, Mich. P.A. 1970 as Amended

For corners in

Iron (County)

	Located In:			Corner Code #
1. Public Land Survey		T 45N	R 34W	G6
		T	R	
		T	R	
	S	T	R	
2. Property Controlling	S 16	T 45N	R 34W	5
in Section	S	T	R	
3. Miscellaneous	S	T	R	
Property in Sec.	S	T	R	

Register of Deeds Stamp & File Number

4. Lot No. _____ , Recorded Plat_____

5. Private Claims

5 May 03 2004
G6 Feb 19 2004

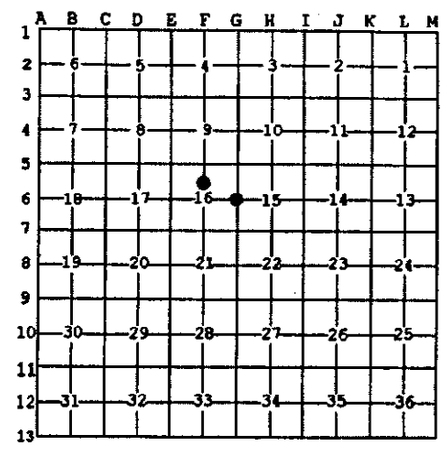

I, Stephan J. Szyszkoski, in a field survey on _____, 20 ____ do hereby state that under requirements of P.A. 74, Michigan P.A. of 1970, the corner points mentioned in lines 1 and 2 above were in conformance with regulations and rules therefore as required in the current manual of survey instructions of the United States Department of the Interior, Bureau of Land Management or by a decree of a Court of Law and /or that the corner points mentioned in lines 3, 4 and 5 above were in conformance with the rules of the Michigan Board of Land Surveyors or by a Decree of a Court of Law; established, re-established, monumented, recovered, found as expressed below:

NOTE: Not more than 2 corners, all in the same town and range, may be recorded on this certificate.

A. Description of original monument and accessories and/or subsequent restoration:

(G6) Quarter corner common to Sections 15-16. 1974: Reestablished by A.O.Enger RLS using proportionate measurement. Set 1"IDx36" I.pipe with 3.5" aluminum cap. W.Birch 5 North 15.3', W.Spruce 6 S66E 5.2'
(5-Sec. 16) North 1/16 corner, Section 16. Not established in the original survey.

B. Description of corner evidence found and/or method applied in restoring or reestablishing corner:

(G6) Found and accepted the 1974 monument in good condition and at record bearing and distance from the two 1974 witness trees. The W.Birch is now a standing dead stub, the Spruce is in good condition with overgrown blazes.
(5-Sec. 16) Established the corner midway and on a straight line between Center of Section 16 1304.48' South and F5 1304.48' North. The lower portion of the monument was bent to conform to an adjacent and obstructing boulder. The top center of the aluminum cap marks the corner position.

C. Description of monument for corner and accessories established to perpetuate locating the position of the corner:

(G6) Found 1"ID I.pipe with alum. MDNR cap. Blazed, scribed, and set measuring nails in:
8" Spruce S06W 33.10' "1/4S NBT"
9" Spruce N52W 27.00' do
10" Spruce N38E 28.50' do
Set nail with tag in the 1974 NBT:
6" Spruce S60E 5.45' old blazes
Bearings are magnetic. Distances are to nail with tag.

(5) Set 1"IDx36" I.pipe with 4" alum. MDNR cap. Blazed, scribed, and set measuring nails in:
4" Maple N27W 4.60' "1/16S BT"
5" Maple N45E 15.65' do
4" Maple S86E 5.60' do
5" Maple S20W 4.70' do
Bearings are magnetic. Distances are to nail with tag. Set sq'd cedar post adjacent.

STATE OF MICHIGAN
STEPHAN J. SZYSZKOSKI
LAND SURVEYOR
No. 33986
LICENSED LAND SURVEYOR

Signed by Stephan J. Szyszkoski Date 5/19/04

Surveyor's Michigan License No. 33986

For the Michigan Department of Natural Resources, Office of Land and Facilities

FORM APPROVED BY MICHIGAN STATE BOARD OF PROFESSIONAL SURVEYORS, JAN. 28, 1971
Revised May 14, 1975
Revised Jan., 1983
Revised Oct., 1995