

**LAND CORNER RECORDATION CERTIFICATE**  
**Filing Requirement of Act 74, Mich. P.A. 1970 as Amended**

For corners in

<u>Iron</u> <small>(County)</small>	Located In:	Corner Code #
1. Public Land Survey	T <u>45N</u> R <u>34W</u>	<u>C2</u>
	T _____ R _____	_____
	T _____ R _____	_____
2. Property Controlling in Section	S _____ T _____ R _____	<u>1</u>
	S <u>5</u> T <u>45N</u> R <u>34W</u>	_____
	S _____ T _____ R _____	_____
3. Miscellaneous Property in Sec.	S _____ T _____ R _____	_____
	S _____ T _____ R _____	_____
4. Lot No. _____, Recorded Plat _____		
5. Private Claims		

**Register of Deeds Stamp & File Number**

	A	B	C	D	E	F	G	H	I	J	K	L	M
1													
2	6		5		4		3		2		1		
3													
4	7		8		9		10		11		12		
5													
6	18		17		16		15		14		13		
7													
8	19		20		21		22		23		24		
9													
10	30		29		28		27		26		25		
11													
12	31		32		33		34		35		36		
13													

Nov 08 2005

I, Stephan J. Szyszkoski, in a field survey on \_\_\_\_\_, 20\_\_ do hereby state that under requirements of P.A. 74, Michigan P.A. of 1970, the corner points mentioned in lines 1 and 2 above were in conformance with regulations and rules therefore as required in the current manual of survey instructions of the United States Department of the Interior, Bureau of Land Management or by a decree of a Court of Law and /or that the corner points mentioned in lines 3, 4 and 5 above were in conformance with the rules of the Michigan Board of Land Surveyors or by a Decree of a Court of Law; established, re-established, monumented, recovered, found as expressed below:

**NOTE: Not more than 2 corners, all in the same town and range, may be recorded on this certificate.**

A. Description of original monument and accessories and/or subsequent restoration:

(C2) Quarter corner common to Sections 5 and 6. 1851 - Established by Guy Carleton, U.S. Deputy Surveyor: S28°W corrected between Secs. 5 & 6 ...40.76 Set quarter post. Y.Birch 14 N35E 25 links, Y.Birch 10 S79W 20 links. ...80.81 Set post corner of Sections 5,6,7,8.

(1-Sec. 5) West 1/16 corner between Section 5 T45N-R34W and Section 32 T46N-R34W. Not established in the original survey. Found no subsequent record.

B. Description of corner evidence found and/or method applied in restoring or reestablishing corner:


(C2) The original post and accessories were not recovered. Found no evidence of the position of the original corner on the ground. Reestablished the corner by single proportionate measurement to the original record, on the Section line between Section corners 2614.44' South and 2660.80' North. Found an old Northern Paper Mills location poster on a dead Spruce stub nearby which indicates a corner position within feet of that monumented and described herein.

(1-Sec. 5) Established the corner on the township line between Section corner 1320.93' West and Quarter corner 1320.93' East.

C. Description of monument for corner and accessories established to perpetuate locating the position of the corner:

(C2) Set 1"IDx32" I.pipe with 4" alum. MDNR cap. Set measuring nails in:  
 6" Balsam N25E 14.8'    mrd "1/4S NBT"  
 4" Maple N40E 26.4'    do  
 9" Tamarack N83E 59.3'    do  
 4" Sugar S67W 21.3'    do  
 Set sq'd cedar post adjacent. Bearings are magnetic. Distances are to nail with tag.

(1) Set 1"IDx32" I.pipe with 4" alum. MDNR cap. Set measuring nails in:  
 8" Spruce N01W 19.1'    mrd "1/16S 8T"  
 5" Maple S53E 49.0    do  
 5" Spruce S46W 26.2'    do  
 7" Spruce N51W 15.8'    do  
 Set sq'd spruce post adjacent. Bearings are magnetic. Distances are to nail with tag.

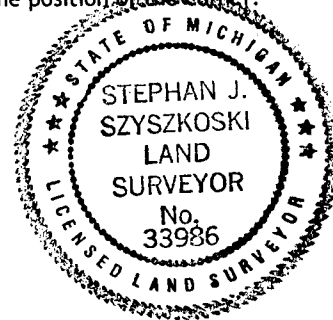

Signed by Stephan J. Szyszkoski  
 Surveyor's Michigan License No. 33986

Date 7/19/06

For the Michigan Department of Natural Resources, Office of Land and Facilities