

**LAND CORNER RECORDATION CERTIFICATE**  
**Filing Requirement of Act 74, Mich. P.A. 1970 as Amended**

For corners in

Iron <small>(County)</small>	Located In:	Corner Code #
1. Public Land Survey	T 45N R 34W	E5
	T 45N R 34W	D3
	T _____ R _____	_____
2. Property Controlling in Section	S _____ T _____ R _____	_____
	S _____ T _____ R _____	_____
3. Miscellaneous Property in Sec.	S _____ T _____ R _____	_____
	S _____ T _____ R _____	_____

Register of Deeds Stamp & File  
Number

4. Lot No. \_\_\_\_\_, Recorded Plat \_\_\_\_\_  
 5. Private Claims

D3 Nov 08 2005  
 E5 Nov 07 2005

I, Stephan J. Szyszkoski, in a field survey on \_\_\_\_\_, 20\_\_\_\_ do hereby state that under requirements of P.A. 74, Michigan P.A. of 1970, the corner points mentioned in lines 1 and 2 above were in conformance with regulations and rules therefore as required in the current manual of survey instructions of the United States Department of the Interior, Bureau of Land Management or by a decree of a Court of Law and /or that the corner points mentioned in lines 3, 4 and 5 above were in conformance with the rules of the Michigan Board of Land Surveyors or by a Decree of a Court of Law; established, re-established, monumented, recovered, found as expressed below:

**NOTE: Not more than 2 corners, all in the same town and range, may be recorded on this certificate.**

	A	B	C	D	E	F	G	H	I	J	K	L	M
1													
2	6		5		4		3		2		1		
3				●									
4	7		8		9		10		11		12		
5					●								
6	18		17		16		15		14		13		
7													
8	19		20		21		22		23		24		
9													
10	30		29		28		27		26		25		
11													
12	31		32		33		34		35		36		
13													

A. Description of original monument and accessories and/or subsequent restoration:


- (E5) Corner common to Sections 8-9-16-17. 1972 - Reestablished by A.O. Enger by double proportionate measurement. Set 1"IDx36" iron pipe with 4" aluminum cap. 6" Sugar N66E 30.0', 8" Sugar N36W 5.2', 10" Sugar S12W 10.6'.
- (D3) Quarter corner common to Sections 5 and 8. 1851 - Established by Guy Carleton, U.S. Deputy Surveyor: S89 deg. 51'W corrected between Secs. 5 & 8 ...40.25 Set quarter post. Sugar 16 S74E 08 links, Y. Birch 18 N43W 29 links. ...80.50 Section corner.

B. Description of corner evidence found and/or method applied in restoring or reestablishing corner:

- (E5) Recovered the 1972 monument in good condition and at record bearing and distance from the 1972 NBTs. The Sugar S12W was cut down to facilitate GPS observations. Left the monument in place and made new witnesses as described below.
- (D3) The original post and accessories were not recovered. Found no evidence of the position of the original corner on the ground. Reestablished the corner by single proportionate measurement to the original record, on the section line between Section corners 2627.57' east and west.

C. Description of monument for corner and accessories established to perpetuate locating the position of the corner:

- |   |   |
|---|---|
| (E5) Found 1"ID I.pipe with 4" alum. MDNR cap. Set measuring nails in:<br>11" Sugar N32W 5.4' overgrown blazes *<br>10" Sugar N70E 30.2' with scribing *<br>12" Sugar S43E 52.9' mrkd "S16 NBT"<br>11" Sugar S78W 34.4' "S17 NBT"<br>3"x3" square post adjacent. Bearings are magnetic. Distances are to nail with tag. * denotes 1972 NBT. | (D3) Set 1"IDx32" I.pipe with 4" alum. MDNR cap. Set measuring nails in:<br>17" Hemlock N43W 6.3' mrkd "1/4S NBT"<br>6" B.Ash N71E 17.9' do<br>18" Hemlock S61E 44.5' do<br>13" Maple S51W 21.5' do<br>Set sq'd cedar post adjacent. Bearings are magnetic. Distances are to nail with tag. |
|---|---|

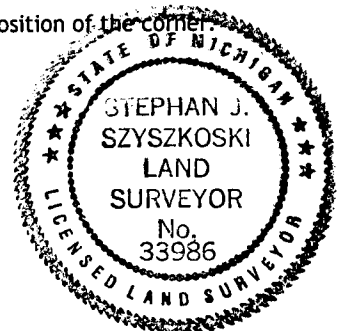

Signed by Stephan J. Szyszkoski  
 Surveyor's Michigan License No. 33986

Date 7/19/06

For the Michigan Department of Natural Resources, Office of Land and Facilities