

**LAND CORNER RECORDATION CERTIFICATE**  
**Filing Requirement of Act 74, Mich. P.A. 1970 as Amended**

For corners in

Iron _____ (County)	Located In:	Corner Code #
1. Public Land Survey	T <u>45N</u> R <u>34W</u>	<u>MC West of J1</u>
	T _____ R _____	_____
	T _____ R _____	_____
	S _____ T _____ R _____	_____
2. Property Controlling in Section	S <u>2</u> T <u>45N</u> R <u>34W</u>	<u>8</u>
	S _____ T _____ R _____	_____
3. Miscellaneous Property in Sec.	S _____ T _____ R _____	_____
	S _____ T _____ R _____	_____

4. Lot No. \_\_\_\_\_, Recorded Plat \_\_\_\_\_  
 5. Private Claims \_\_\_\_\_

May 14 2007

I, Stephan J. Szyszkoski, in a field survey on \_\_\_\_\_, 20\_\_\_\_ do hereby state that under requirements of P.A. 74, Michigan P.A. of 1970, the corner points mentioned in lines 1 and 2 above were in conformance with regulations and rules therefore as required in the current manual of survey instructions of the United States Department of the Interior, Bureau of Land Management or by a decree of a Court of Law and /or that the corner points mentioned in lines 3, 4 and 5 above were in conformance with the rules of the Michigan Board of Land Surveyors or by a Decree of a Court of Law; established, re-established, monumented, recovered, found as expressed below:

**NOTE: Not more than 2 corners, all in the same town and range, may be recorded on this certificate.**

A. Description of original monument and accessories and/or subsequent restoration:


(MC west of J1) Meander corner on the Township line on west bank of the "Wide Waters" of the Net River between Sec. 2 T45N-R34W and Sec. 35 T46N-R34W. 1846 - Established by Wm.A.Burt, Deputy Surveyor 60.95 chains west of Section corner K1. Set meander post. B. Ash 7 N48W 53 links. Found no subsequent record.  
 (8-Sec. 2) West 1/16 corner, Section 2. Not established in the original survey.

B. Description of corner evidence found and/or method applied in restoring or reestablishing corner:

(MC west of J1) The original post and accessories were not recovered. Reestablished the corner on the Township line between monumented corners H1 and K1 and at index-corrected record GLO distance west of corner K1 (4026.83' M, 60.95 ch. R). Though the position for the MC falls on soil suitable for monumentation, a monument was not placed at the position. A Witness Corner to the MC was placed on the Township line 7.13' east of the MC position. The Witness Corner is 15' west of the water's edge.  
 (8-Sec. 2) Established the corner at the intersection of the E-W 1/4 line (parallel to line between Section corners I3 and K3) and West N-S 1/16 line (mean bearing of N-S 1/4 line and West line of Section).

C. Description of monument for corner and accessories established to perpetuate locating the position of the corner:

(MC) Set 1"IDx32" I.pipe with 4" alum. MDNR cap for a Witness corner. The MC is 7.13' west. Set measuring nails in: 10" Cherry N02E 32.8'      mrkd "WC MC" 10" Ash S39W 82.9'      do 3" Ash N79W 4.8'      do 12" Cherry N33W 45.2'      do Set sq'd Balsam post adjacent. Bearings are magnetic. Distances are to nail with tag.	(8) Set 1"IDx32" I.pipe with 4" alum. MDNR cap. Set measuring nails in: 6" Sugar North 14.0'      mrkd "1/16S BT" 10" Sugar S72E 58.4'      do 8" Sugar S12W 8.7'      do 8" Sugar N60W 6.1'      do Set sq'd spruce post adjacent. Bearings are magnetic. Distances are to nail with tag.
--	--

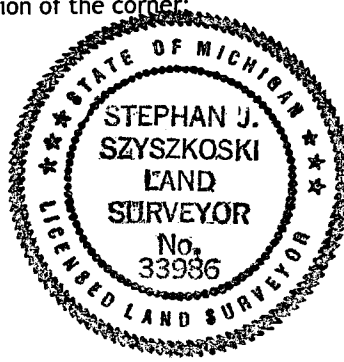

Signed by Stephan J. Szyszkoski  
 Surveyor's Michigan License No. 33986

Date 5/31/07

Register of Deeds Stamp & File Number

	A	B	C	D	E	F	G	H	I	J	K	L	M
1										●			
2	6		5		4		3			●	2		1
3													
4	7		8		9		10			11		12	
5													
6	18		17		16		15			14		13	
7													
8	19		20		21		22			23		24	
9													
10	30		29		28		27			26		25	
11													
12	31		32		33		34			35		36	
13													