LAND CORNER RECORDATION CERTIFICATE
Filing Requirement of Act 74, Mich. P.A. 1970 as Amended

For corners in

Iron
(County)

	Located In:	Corner Code #
1. Public Land Survey	T 45N R 34W	J2
	T___ R___	
	T___ R___	
	S___ T___ R___	
2. Property Controlling	S___ T___ R___	
in Section	S___ T___ R___	
3. Miscellaneous	S___ T___ R___	
Property in Sec.	S___ T___ R___	

Register of Deeds Stamp & File Number

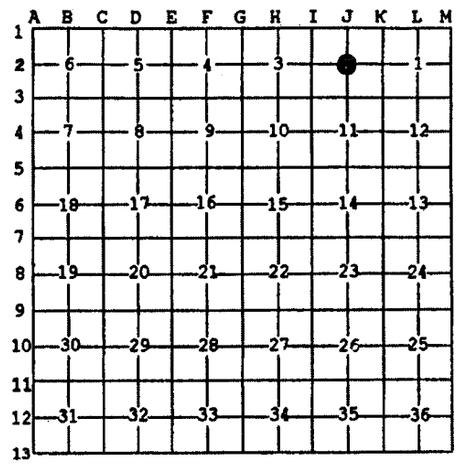

4. Lot No. _____ , Recorded Plat_____
5. Private Claims

May 10 2007

I, Stephan J. Szyszkoski, in a field survey on _____, 20 ____ do hereby state that under requirements of P.A. 74, Michigan P.A. of 1970, the corner points mentioned in lines 1 and 2 above were in conformance with regulations and rules therefore as required in the current manual of survey instructions of the United States Department of the Interior, Bureau of Land Management or by a decree of a Court of Law and /or that the corner points mentioned in lines 3, 4 and 5 above were in conformance with the rules of the Michigan Board of Land Surveyors or by a Decree of a Court of Law; established, re-established, monumented, recovered, found as expressed below:

NOTE: Not more than 2 corners, all in the same town and range, may be recorded on this certificate.

A. Description of original monument and accessories and/or subsequent restoration:

(J2) Center of Section 2. Not established in the original survey. Found no subsequent record.

B. Description of corner evidence found and/or method applied in restoring or reestablishing corner:

(J2) Established the corner at the intersection of 1/4 lines. The N-S 1/4 line is the mean of the bearings of the West line of Section 2 (itself a mean of lines G3-G1 and K3-K1) and a line between Section corners K3-K1. The E-W 1/4 line is parallel to a line between Section corners I3-K3. S09W 24.9' from the position thus established, I found a sq'd 17" Spruce with Northern Paper Mills tag dated 1961 identifying the tree as the corner. I regard the tagged tree as an approximation of the corner position and do not accept it as marking the position for the corner.

C. Description of monument for corner and accessories established to perpetuate locating the position of the corner:

(J2) Set 1"IDx32" I.pipe with 4" alum.
MDNR cap. Set measuring nails in:
9" Maple N37E 7.8' mrkd "C1/4 BT"
6" Maple S74E 7.2' do
17" Spruce S09W 24.9' do
19" Cedar S79W 13.3' do
Bearings are magnetic. Distances are to nail with tag. Sq'd a 9" Maple, adjacent.

STATE OF MICHIGAN
STEPHAN J. SZYSZKOSKI
LAND SURVEYOR
No. 33986
LICENSED LAND SURVEYOR

Signed by Stephan J. Szyszkoski Date 5/31/07

Surveyor's Michigan License No. 33986

For the Michigan Department of Natural Resources, Office of Land and Facilities

FORM APPROVED BY MICHIGAN STATE BOARD OF PROFESSIONAL SURVEYORS, JAN. 28, 1971
Revised May 14, 1975
Revised Jan., 1983
Rervised Oct., 1995